


WELL PLUGGING RECORD

Give All Information Completely
Make Required Affidavit
Mail or Deliver Report to:
Conservation Division
State Corporation Commission
800 Biring Building
Wichita, Kansas

NORTH

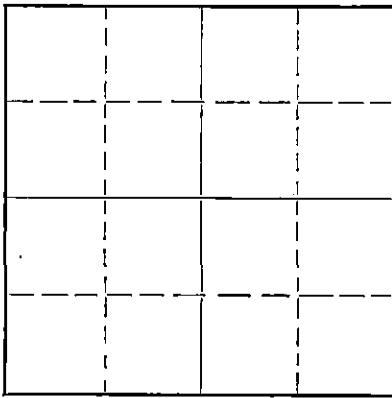

Locate well correctly on above Section Plat

Stafford County. Sec. 34 Twp. 21 Rge. (E) 14 (W)
Location as "NE/CNW $\frac{1}{4}$ SW $\frac{1}{4}$ " or footage from lines SW NE NW $\frac{1}{4}$
Lease Owner Max Cohen
Lease Name McGinty Well No. 4
Office Address Brown Building, Wichita, Kansas
Character of Well (completed as Oil, Gas or Dry Hole) dry
Date well completed July 15 1951
Application for plugging filed July 15 1951
Application for plugging approved July 15 1951
Plugging commenced July 15 1951
Plugging completed July 15 1951
Reason for abandonment of well or producing formation dry
If a producing well is abandoned, date of last production 19
Was permission obtained from the Conservation Division or its agents before plugging was commenced? Yes

Name of Conservation Agent who supervised plugging of this well C. D. Stough
Producing formation Depth to top Bottom Total Depth of Well 37.89 Feet
Show depth and thickness of all water, oil and gas formations.

OIL, GAS OR WATER RECORDS

CASING RECORD

Formation	Content	From	To	Size	Put In	Pulled Out
				8/78	275	None

Describe in detail the manner in which the well was plugged, indicating where the mud fluid was placed and the method or methods used in introducing it into the hole. If cement or other plugs were used, state the character of same and depth placed, from feet to feet for each plug set.

Filled hole with heavy mud to 270 ft., pushed plug down and put 15 sacks of cement on top of plug, pushed plug to 30 ft., mixed 10 sacks of cement and filled to bottom of cellar.

7-24-1951

JUL 23 1951

(If additional description is necessary, use BACK of this sheet)

Correspondence regarding this well should be addressed to M. B. Armer
Address 710 Petroleum Bldg, Wichita, Kansas

STATE OF Kansas, COUNTY OF Sedgwick, ss.
L. C. Sponenberg (employee of M. B. Armer) of the above-described well, being first duly sworn on oath, says: That I have knowledge of the facts, statements, and matters herein contained and the log of the above-described well as filed and that the same are true and correct. So help me God.

(Signature) *L. C. Sponenberg*

710 Petroleum Bldg., Wichita, Kansas (Address)

SUBSCRIBED AND SWORN TO before me this 20th day of July 1951

My commission expires Sept. 17, 1951

Hazel Walton
Notary Public.

My commission expires

PLUGGING
FILE SEC 34 T 21 R 14
BOOK PAGE 96 LINE 10

LOG

Company: Max Cohen
 Contractor: M. B. Armer (Ideco rig)
 Drilling commenced: 7/3/51
 Drilling completed: 7/16/51
 Elevation: Est. 1945 R. B.

Farm: McGinty - well #4
 Location: SW NE NW Sec. 34-21-14W,
 Stafford County, Kansas
 Casing record: 8-5/8" set @ 275'
 cemen ed w/275 sacks

(figures below indicate bottoms)

Soil and sand	255
Shale	275
Shale, sand & red bed	575
Shale & red bed	840
Anhydrite	870
Shale & shells	1725
Brok. lime & shale	1775
Lime & shale	2425
Shel & lime streaks	2625
Shale & lime	3410
Lime	3610
Lime & shale	3694
Lime & chert	3705
Lime & shale	3745
Shale	3787
Lime	3789
Rotary Total Depth	3789 D & A.

FORMATION TOPS:

Heebner	3291
Toronto	3319
Brown Lime	3408
Kansas City	3420
Viola	3698
Simpson	3736
Arbuckle	3787

I hereby certify that this is a true and correct log of the above described well as shown by the drilling reports.

M. B. ARMER

By *Guspen*

STATE OF KANSAS)
) SS
 COUNTY OF SEDGWICK)

Subscribed and sworn to before me, a notary public, in and for said County and State this 23rd day of July, 1951.

Hazel Walton
 Notary Public

My commission expires Sept. 17, 1951.

RECEIVED
 JUL 24 1951
 DIVISION

PLUGGING
 FILE SEC 34-21-14W
 BOOK PAGE 96 LINE 15