


STATE OF KANSAS
STATE CORPORATION COMMISSION

WELL PLUGGING RECORD

Give All Information Completely
Make Required Affidavit
Mail or Deliver Report to:
Conservation Division
State Corporation Commission
211 No. Broadway
Wichita, Kansas

NORTH

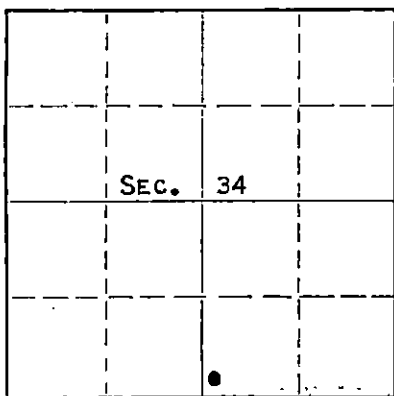

Locate well correctly on above
Section Plat

STAFFORD County. Sec. 34 Twp. 21 Rge. 14 (E) (W)
Location as "NE/CNW/SW" or footage from lines SW SW SE
Lease Owner PETROLEUM, INC.
Lease Name SCHARTZ "B" Well No. 1
Office Address ROUTE 2, GREAT BEND, KANSAS
Character of Well (completed as Oil, Gas or Dry Hole) OIL
Date well completed OCTOBER 26 1952
Application for plugging filed DECEMBER 26 1961
Application for plugging approved DECEMBER 26 1961
Plugging commenced DECEMBER 26 1961
Plugging completed DECEMBER 30 1961
Reason for abandonment of well or producing formation DEPLETION OF PRODUCIBLE FORMATIONS.

If a producing well is abandoned, date of last production NOVEMBER 16 1960
Was permission obtained from the Conservation Division or its agents before plugging was commenced? YES

Name of Conservation Agent who supervised plugging of this well MR. W. L. LACKAMP, JR.
Producing formation LANSING K.C. Depth to top 3426 Bottom 3654 Total Depth of Well 3825 Feet
Show depth and thickness of all water, oil and gas formations.

OIL, GAS OR WATER RECORDS

CASING RECORD

FORMATION	CONTENT	FROM	TO	SIZE	PUT IN	PULLED OUT
LANSING K.C.	WATER & MUD	3567	3576	8-5/8"	234'	NONE
	OIL	3553	3556	5 1/2"	3675'	3366'

Describe in detail the manner in which the well was plugged, indicating where the mud fluid was placed and the method or methods used in introducing it into the hole. If cement or other plugs were used, state the character of same and depth placed, from _____ feet to _____ feet for each plug set.

PLUGGED BACK T.D. 3640', FILLED BOTTOM OF HOLE FROM 3640' TO 3556' WITH CRUSHED ROCK, FOLLOWED BY 4 SACKS CEMENT. FILLED HOLE WITH MUD. GLOBE CEMENTING COMPANY SQUEEZED WITH 92 SACKS CEMENT.

RECEIVED
STATE CORPORATION COMMISSION
JAN 1 1962
CONSERVATION DIVISION
Wichita, Kansas
1-12-1962

(If additional description is necessary, use BACK of this sheet)

Name of Plugging Contractor SOUTHWEST CASING PULLING CO., INC.
Address BOX 364, GREAT BEND, KANSAS

STATE OF KANSAS, COUNTY OF BARTON, ss.
DON SEARLE (employee of owner) or (owner) of the above-described well, being first duly sworn on oath, says: That I have knowledge of the facts, statements, and matters herein contained and the log of the above-described well as filed and that the same are true and correct. So help me God. DON SEARLE, DIST. PROD. SUPT.
(Signature) Don Searle
ROUTE 2, GREAT BEND, KANSAS (Address)


SUBSCRIBED AND SWORN to before me this 10TH day of JANUARY, 1962
Arthur J. Wiles
Notary Public.

My commission expires APRIL 14, 1963



Give All Information Completely
Make Required Affidavit
Mail or Deliver Report to:
Conservation Division
State Corporation Commission
212 North Market, Insurance Bldg.
Wichita, Kansas

WELL PLUGGING RECORD

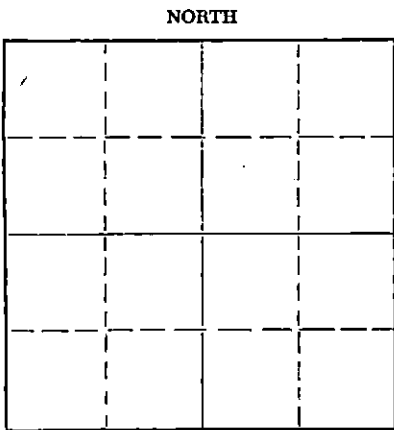

Locate well correctly on above Section Plat

Stafford County, Sec. 34 Twp. 21 Rge. 14 (E) (W) X
Location as "NE/CNWxSWx" or footage from lines SW SW SE
Lease Owner Petroleum Inc.
Lease Name Schartz "B" Well No. 1
Office Address Route #2
Character of Well (completed as Oil, Gas or Dry Hole)
Date well completed 19
Application for plugging filed 12-26-61 19
Application for plugging approved 19
Plugging commenced 12-26-61 19
Plugging completed 12-30-61 19
Reason for abandonment of well or producing formation dry

If a producing well is abandoned, date of last production 19
Was permission obtained from the Conservation Division or its agents before plugging was commenced?

Name of Conservation Agent who supervised plugging of this well Frank Broadfoot
Producing formation Depth to top Bottom Total Depth of Well 3640 Feet
Show depth and thickness of all water, oil and gas formations.

OIL, GAS OR WATER RECORDS

CASING RECORD

FORMATION	CONTENT	FROM	TO	SIZE	PUT IN	PULLED OUT

Describe in detail the manner in which the well was plugged, indicating where the mud fluid was placed and the method or methods used in introducing it into the hole. If cement or other plugs were used, state the character of same and depth placed, from feet to feet for each plug set.

Sanded back to 3556' with 4 sacks cement
Set over night bridge
Pumped in 92 sacks cement to plug hole.

JAN 3 1962

(If additional description is necessary, use BACK of this sheet)

Name of Plugging Contractor Southwest Casing Pulling Co., Inc.
Address Box 364, Great Bend, Kansas

STATE OF Kansas, COUNTY OF Barton, ss.
Southwest Casing Pulling Co., Inc. (employee of owner) or (owner or operator) of the above-described well, being first duly sworn on oath, says: That I have knowledge of the facts, statements, and matters herein contained and the log of the above-described well as filed and that the same are true and correct. So help me God.

(Signature) W. C. Spencer
Box 364, Great Bend, Kansas
(Address)

SUBSCRIBED AND SWORN TO before me this 2 day of January, 1962

My commission expires 24 October 1964
Sidney D. Miller
Notary Public.



DRILLER'S LOG SCHATZ 'B' #1

Petroleum, Inc., Operator

Section 34, Twp. 21S, Rge 14W

Garvey Drilling Company, Contractor

Location: SW SW SE

Drilling Commenced: September 3, 1952

County: Stafford County, Kansas

Drilling Completed: September 13, 1952

R.T.D.: 3825'

Casing Record: 8 5/8" @ 234' w/175 sax
5 1/2" @ 3675' w/50 sax

Production: Lansing-Kansas City

Figures below indicate bottom of formation:

4 Sand
15 Shale
90 Sand & Shale
185 Sand
305 Shale & Shells
395 Sand
840 Shale, Shells & Red Bed
866 Anhydrite
1805 Shale & Shells
1850 Lime & Shale
2040 Lime
2373 Lime & Shale
2825 Shale & Shells
3240 Lime & Shale
3673 Lime
3742 Conglomerate
3796 Shale
3825 Lime

Tops:

Heebner: 3296 (-1354)
Brown Lime: 3416 (-1474)
Lansing: 3425 (-1484)
Arbuckle: 3796 (-1854)

DST #1, 3564-80, open 1 hr., rec. 300' oil,
1250# BHP.

DST #2, 3580-96, open 45 mins., rec. 10'
mud, 0# BHP

DST #3, 3600-3620, open 1/2 hr., rec. 15'
mud, 0# BHP.

RECEIVED
STATE CORPORATION COMMISSION

JAN 1 1962

CONSERVATION DIVISION
Wichita, Kansas

3825' R.T.D.

I hereby certify that this is a true and correct log of the above mentioned well.

PETROLEUM, INC.

By W W Fisher

STATE OF KANSAS)
) SS:
COUNTY OF SEDGWICK)

Subscribed to and sworn to before me, this 26th day of September, 1952.

Charlotte Hedman
Notary Public

My commission expires: October 13, 1954