

WELL PLUGGING RECORD

Give All Information Completely
Make Required Affidavit
Mail or Deliver Report to:
Conservation Division
State Corporation Commission
Seminole Building
Wichita, Kansas

Stafford County, Sec. 34 Twp. 21 Rge. 14 (E) (W)

Location as "NE/CNW/SW" or footage from lines SW-SW-SW

Lease Owner PETROLEUM, Incorporated

Lease Name Schartz "B" Well No. 2

Office Address Rural Route 2, Great Bend, Kansas

Character of Well (completed as Oil, Gas or Dry Hole) Dry Hole

Date well completed June 1, 1955 19

Application for plugging filed June 30, 1955

Application for plugging approved July 6 1955

Plugging commenced July 23 1955


Plugging completed July 26 1955

Reason for abandonment of well or producing formation

No producible zones

If a producing well is abandoned, date of last production --- 19

Was permission obtained from the Conservation Division or its agents before plugging was commenced? Yes

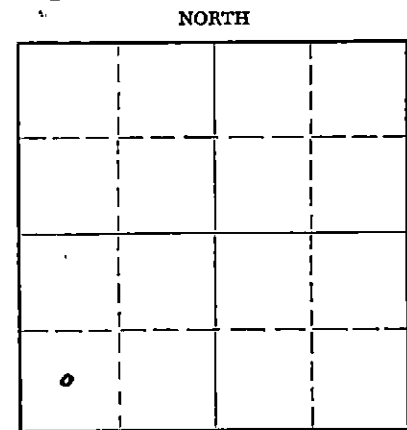

Locate well correctly on above Section Plat

Name of Conservation Agent who supervised plugging of this well W H Horner

Producing formation Kansas City Depth to top 3,422' Bottom 3647' Total Depth of Well 3830' Feet

Show depth and thickness of all water, oil and gas formations.

OIL, GAS OR WATER RECORDS

CASING RECORD

FORMATION	CONTENT	FROM	TO	SIZE	PUT IN	PULLED OUT
Kansas City	Oil & Water	3584'	3588'	8-5/8"	238'	None
Kansas City	Oil & Water	3547 1/2'	3550 1/2'	4 1/2" OD	3,720'	2,033'

Describe in detail the manner in which the well was plugged, indicating where the mud fluid was placed and the method or methods used in introducing it into the hole. If cement or other plugs were used, state the character of same and depth placed, from _____ feet to _____ feet for each plug set.

(Drilled out to 3,625') Filled hole with crushed rock from 3625' to 3540' and placed five sacks cement from 3540' to 3501'. Globe Oilwell Cementing Inc. pumped down 20 sacks of Controlbar to kill Dakota water flow, and then pumped in 100 sacks cement to fill surface pipe. Then finished filling to bottom of well cellar with cement.

RECEIVED

STATE CORPORATION COMMISSION

AUG 2 1955

CONSERVATION DIVISION

Wichita, Kansas

(If additional description is necessary, use BACK of this sheet)

Name of Plugging Contractor Morgan Well Plugging Service (License #43)

Address 102 West 18th Street, Hutchinson, Kansas

STATE OF KANSAS COUNTY OF SEDGWICK, ss.

C. J. Wiltse (employee of owner) or (owner or operator) of the above-described well, being first duly sworn on oath, says: That I have knowledge of the facts, statements, and matters herein contained and the log of the above-described well as filed and that the same are true and correct. So help me God.

(Signature)

Rural Route 2, Great Bend, Kansas

(Address)

SUBSCRIBED AND SWORN TO before me this 29th day of JULY, 19 55

My commission expires July 8, 1958

D.M. KENNEDY

Notary Public.

PLUGGING
FILE SEC 34 T 21 R 14 W
BOOK PAGE 132 LINE 8

WELL LOG

15.185.009-85.0000

COMPANY, Petroleum, Inc.

SEC. 34 T. 21S R. 14W

FARM SCHWARTZ 'B'

NO. 2

LOC. SW SW SW


TOTAL DEPTH 3830'

COUNTY Stafford

COMM. May 13, 1955

COMP. May 24, 1955

CONTRACTOR Carvey Drilling Company

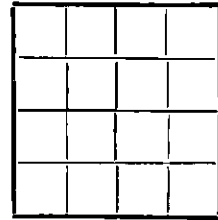

CASING 3-5/8" @ 238' w/200 S&X
4-1/2" @ 3720' w/50 S&X

ELEVATION 1943 DF
1945 AB

PRODUCTION Arbuckle

FIGURES INDICATE BOTTOM OF FORMATIONS

40	Surface Clay & Sand
200	Sand
240	Shale
390	Shale & Sand
854	Red Bed
835	Anhydrite
1050	Shale & Shells
1350	Shale
1580	Salt & Shale
1750	Shale & Shells
3115	Lime & Shale
3250	Lime
3450	Lime & Shale
3505	Lime
3557	Lime & Shale
3670	Lime
3730	Lime & Shale & Chert
3747	Lime & Chert
3830	Lime & Shale

Geological Tops

Neoburns:	3297 (-1352)
Brown Lime:	3416 (-1471)
Lancing:	3426 (-1481)
Conglomerate:	3705 (-1760)
Viola:	3712 (-1767)
Simpson:	3752 (-1807)
Arbuckle:	3800 (-1859)

R. T. C. 3830'

State of KANSAS
County of STAFFORD } ss:

I, Karl E. Becker of Petroleum, Inc.

upon oath state that the above and foregoing is a true and correct copy of the log of the SCHWARTZ 'B' #2 well

PLUGGING
FILE SEC 34 T 21 R 14W
BOOK PAGE 132 LINE 8

Subscribed and sworn to before me this 14th day of June 1955

My Commission Expires: 6-11-58

Karl E. Becker
NOTARY PUBLIC