

15.185.21066.0000


STATE OF KANSAS
STATE CORPORATION COMMISSION

WELL PLUGGING RECORD

Give All Information Completely
Make Required Affidavit
Mail or Deliver Report to
Conservation Division
State Corporation Comm.
245 North Water
Wichita, KS 67202

Stafford County, Sec. 36 Twp. 21S Rge. 14W ~~EXX~~
Location as "NE/CNW $\frac{1}{4}$ SW $\frac{1}{4}$ " or footage from lines
SE SW SE

Lease Owner American Energies Corporation
Lease Name McGinty Well No. 1-A
Office Address 575 Fourth Financial Center, Wichita, KS
Character of Well (Completed as Oil, Gas or Dry Hole)
Dry Hole

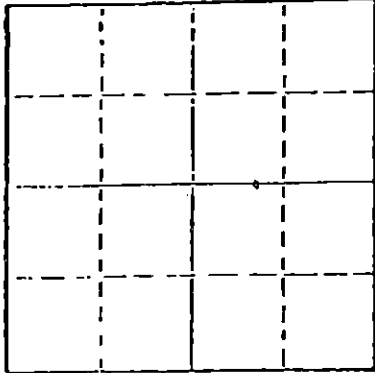

Locate well correctly on above
Section Plat

Date Well completed June 12 1980
Application for plugging filed June 12 1980
Application for plugging approved June 12 1980
Plugging commenced June 12 1980
Plugging completed June 12 1980
Reason for abandonment of well or producing formation

If a producing well is abandoned, date of last production 19

Was permission obtained from the Conservation Division or its agents before plugging was commenced? Yes

Name of Conservation Agent who supervised plugging of this well Bill Owens, Pratt, KS
Producing formation Depth to top Bottom Total Depth of Well 3753
Show depth and thickness of all water, oil and gas formations.

OIL, GAS OR WATER RECORDS

CASING RECORD

FORMATION	CONTENT	FROM	TO	SIZE	PUT IN	PULLED OUT

Describe in detail the manner in which the well was plugged, indicating where the mud fluid was placed and the method or methods used in introducing it into the hold. If cement or other plugs were used, state the character of same and depth placed, from feet to feet for each plug set.

Plugged hole as follows:

- Plug w/40 sx @ 600'
- plug w/40 sx @ 330'
- plug w/10 sx in rat hole
- plug w/3 sx in water well

Plug job complete at 8:15 p.m. 6-12-80

State Plugger: Bill Owens
Bill Roach

6-17-1980
JUN 17 1980

(If additional description is necessary, use BACK of this sheet)

Name of Plugging Contractor Husky Drilling Co., Inc.

STATE OF Kansas COUNTY OF SEDGWICK, ss.
Jon T. Williams, Jr. (employee of owner) or (owner or operator)
of the above-described well, being first duly sworn on oath, says: That I have knowledge of the facts, statements, and matters herein contained and the log of the above-described well as filed and that the same are true and correct. So help me God.

(Signature)

200 E. First, Suite 500, Wichita, KS 67202
(Address)

SUBSCRIBED AND SWORN TO before me this 16th day of June, 1980

Geraldine Stewart
Geraldine Stewart Notary Public.

My commission expires January 12, 1981





200 E. First, Suite 500
~~800 Biting Blvd~~
Wichita, Kansas 67202
Phone 316 - 263-7904
Mobile Phone 316 - 793-7859 Unit 7070

June 16, 1980

WELL LOG-----McGinty #1-A
Located: SE SW SE of Sec. 36-21S-14W, Stafford Co., Kansas

OWNER: American Energies Corporation
ROTARY CONTRACTOR: Husky Drilling Co., Inc.

COMMENCED: June 4, 1980
COMPLETED: June 12, 1980

Rotary Total Depth: 3753'

LOG

CASING RECORD

0 - 40	Clay & Sand
40 - 285	Sand
285 - 328	Shale
328 - 808	Shale & Red Bed
808 - 825	Anhydrite
825 - 2058	Shale & shells
2058 - 3565	Shale & lime
3565 - 3627	Lime
3627 - 3748	Lime & shale
3748 - 3753	Lime

Ran 9 jts., used 28#, 8-5/8" casing
tallied 329.26' set @ 328 KB w/250sx
60/40 pozmix 2%gel, 3%cc, cem did
circ, plug down @ 11:00 pm 6-4-80.

Plugged @ 6:15 p.m. on 6-12-80.

RECEIVED
OIL & GAS COMMISSION
JUN 17 1980
REGULATORY DIVISION