


Give All Information Completely  
Make Required Affidavit  
Mail or Deliver Report to:  
Conservation Division  
State Corporation Commission  
P. O. Box 17027  
Wichita, Kansas 67217  
NORTH

WELL PLUGGING RECORD

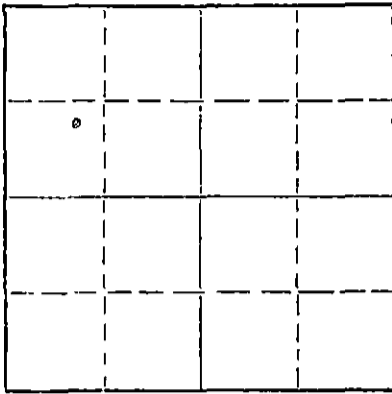

Locate well correctly on above  
Section Plat

Stafford County, Sec. 36 Twp. 21 Rge. (E) 14 (W)  
Location as "NE/CNW/SW" or footage from lines NE SW NW  
Lease Owner Specter Pipe And Supply, Inc.  
Lease Name Keenan Well No. 1  
Office Address Box 169, Russell, Kansas 67665  
Character of Well (completed as Oil, Gas or Dry Hole) oil  
Date well completed 19  
Application for plugging filed 19  
Application for plugging approved 19  
Plugging commenced August 21 1973  
Plugging completed August 31 1973  
Reason for abandonment of well or producing formation depleted

If a producing well is abandoned, date of last production 19  
Was permission obtained from the Conservation Division or its agents before plugging was commenced? YES

Name of Conservation Agent who supervised plugging of this well G. R. Biberstein  
Producing formation Depth to top Bottom Total Depth of Well 3801 Feet  
Show depth and thickness of all water, oil and gas formations.

OIL, GAS OR WATER RECORDS

CASING RECORD

FORMATION	CONTENT	FROM	TO	SIZE	PUT IN	PULLED OUT
		0	209'	8 5/8"	209'	none
			3800'	4 1/2"	3800'	2017.89

Describe in detail the manner in which the well was plugged, indicating where the mud fluid was placed and the method or methods used in introducing it into the hole. If cement or other plugs were used, state the character of same and depth placed, from feet to feet for each plug set.

Sanded back to 3565' and dumped 4 sacks of cement.  
Pumped in 2 sacks of hulls, 10 sacks of gel and 100 sacks of cement.

RECEIVED  
STATE CORPORATION COMMISSION  
SEP 5 1973  
CONSERVATION DIVISION  
Wichita, Kansas

(If additional description is necessary, use BACK of this sheet)  
Name of Plugging Contractor PIPE PULLERS, INC.  
Address Box 486, Ellinwood, Kansas 67526

STATE OF KANSAS, COUNTY OF BARTON, ss.  
Evelyn Roth (employee of owner) or (owner or operator) of the above-described well, being first duly sworn on oath, says: That I have knowledge of the facts, statements, and matters herein contained and the log of the above-described well as filed and that the same are true and correct. So help me God.

(Signature) Evelyn Roth  
Ellinwood, Kansas (Address)

SUBSCRIBED AND SWORN TO before me this 4th day of September, 1973

My commission expires Feb. 10, 1974  
Searge A. Meyer Notary Public

36-21-14W  
NE SW NW


KANSAS GEOLOGICAL SOCIETY  
KANSAS WELL LOG BUREAU - KANSAS WELL SAMPLE BUREAU  
KANSAS GEOLOGICAL SOCIETY BUILDING  
508 EAST MURDOCK - WICHITA, KANSAS

15.185.20419.0000


KANSAS GEOLOGICAL SOCIETY  
508 East Murdock  
Wichita, KANSAS

Hershberger Explorations, Inc.

SEC. 36 T. 21S. R. 14W  
LOC. NE SW NW

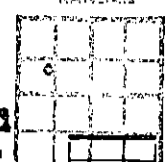

COUNTY Stafford  
KANSAS

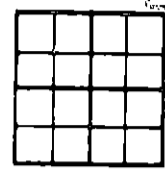

AUG 22 1972 Keenan

NO. 1

TOTAL DEPTH 3,801'  
COMM. June 26, 1972

COMP. July 7, 1972

SHOT OR TREATED  
CONTRACTOR H-30, Inc.  
ISSUED

CASING

20	10		
15		8-5/8" 209' cemented w/200 sxs cement	ELEVATION 1,928' KB
12	6		
13	5	4 1/2" 3,800' cemented w/125 sxs cement	PRODUCTION

FIGURES INDICATE BOTTOM OF FORMATIONS

Sand and Shale	335'
Redbed	825'
Anhydrite	845'
Shale	1,600'
Lime and Shale	2,375'
Shale and Lime	2,960'
Lime and Shale	3,210'
Lime	3,280'
Lime and Shale	3,350'
Shale	3,400'
Lime	3,660'
Cherty Lime and Shale	3,738'
Shale	3,791'
Lime	3,801'
Rotary Total Depth	3,801'

I hereby certify the above and foregoing to be a true and correct log of the above described well as shown by the drilling reports.

H-30, INC.

*Dean Britting*  
Dean Britting

State of Kansas }  
County of Sedgwick } ss:

Subscribed and Sworn to before me a Notary Public in and for said county and state this 12th. day of July, 1972.

*Elsie Willison*  
Elsie Willison - Notary Public



Commission Expires:  
June 30, 1974

LOG TOPS

* SC	825
HEEB	3279
TCR	3301
BN LM	3402
LANS	3413
VIOLA OHT	3674
SIMP	3732
ARD	3785
TD	3801
* DRILLERS TOP	

RECEIVED  
STATE CORPORATION COMMISSION  
SEP 10 1973  
CONSERVATION DIVISION  
Wichita, Kansas