


WELL PLUGGING RECORD

Give All Information Completely
Make Required Affidavit
Mail or Deliver Report to:
Conservation Division
State Corporation Commission
211 No. Broadway
Wichita, Kansas

Stafford County, Sec. 36 Twp. 21S Rge. (E) 14 (W)

Location as "NE/CNW/SW" or footage from lines NE NE NE
Lease Owner Bowers Drilling Company, Inc.
Lease Name Curtis Well No. 1
Office Address 416 Union Center, Wichita, Kansas
Character of Well (completed as Oil, Gas or Dry Hole) Dry Hole
Date well completed March 31 19 64
Application for plugging filed April 3 19 64
Application for plugging approved March 31 19 64
Plugging commenced March 31 19 64
Plugging completed March 31 19 64
Reason for abandonment of well or producing formation Dry Hole

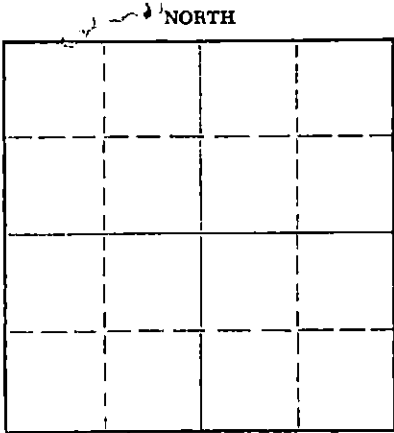

Locate well correctly on above Section Plat

If a producing well is abandoned, date of last production 19
Was permission obtained from the Conservation Division or its agents before plugging was commenced?

Name of Conservation Agent who supervised plugging of this well
Producing formation Depth to top Bottom Total Depth of Well 3766 Feet
Show depth and thickness of all water, oil and gas formations.

OIL, GAS OR WATER RECORDS

CASING RECORD

FORMATION	CONTENT	FROM	TO	SIZE	PUT IN	PULLED OUT
				8-5/8"	357'	

Describe in detail the manner in which the well was plugged, indicating where the mud fluid was placed and the method or methods used in introducing it into the hole. If cement or other plugs were used, state the character of same and depth placed, from feet to feet for each plug set.

Filled with heavy mud to 300'
Set first plug at 300' with 25 sax cement
Filled with heavy mud to 40'
Set second plug at 40' with 10 sax cement, 2 sax in rathole

RECEIVED
STATE CORPORATION COMMISSION

APR 9 1964

4-9-1964

CONSERVATION DIVISION
Wichita, Kansas

(If additional description is necessary, use BACK of this sheet)
Name of Plugging Contractor Bowers Drilling Company, Inc.
Address 416 Union Center Building, Wichita, Kansas

STATE OF KANSAS, COUNTY OF SEDGWICK, ss.
Emil E. Bowers (employee of owner) or (owner or operator) of the above-described well, being first duly sworn on oath, says: That I have knowledge of the facts, statements, and matters herein contained and the log of the above-described well as filed and that the same are true and correct. So help me God.

(Signature) Emil E. Bowers
416 Union Center, Wichita, Kansas
(Address)

SUBSCRIBED AND SWORN TO before me this 3rd day of April, 19 64

My commission expires May 1, 1966

Hanna J. Miller
Notary Public.



WELL LOG

COMPANY: Bowers Drilling Company, Inc.
 CONTRACTOR: Bowers Drilling Company, Inc.
 FARM: Curtis #1
 LOCATION: NE NE NE Section 36-21S-14W
 Stafford County, Kansas
 COMMENCED: 3-23-64
 COMPLETED: 3-31-64
 ELEVATION: 1922 Kelly Bushing

0 - 1165	Redbed, shale and shells.	Set 8-5/8" casing at 357' with 350
1165 - 1938	Shale	sacks
1938 - 2155	Shale and lime	
2155 - 2931	Shale	
2931 - 3160	Shale and lime	
3160 - 3275	Lime	
3275 - 3440	Lime and shale	
3440 - 3585	Lime	
3585 - 3685	Lime, shale and chert	
3685 - 3752	Lime	
3752 - 3766	Arbuckle	
3766	T. D.	

RECEIVED
 STATE CORPORATION COMMISSION
 APR 9 1964
 CONSERVATION DIVISION
 Wichita, Kansas

SAMPLE TOPS:

Heebner	3260	Conglomerate	3633
Brown Limestone	3381	Viola	3649
Lansing/Kansas City	3391	Simpson	3700
Base/Kansas City	3621	Arbuckle	3752

STATE OF KANSAS)
) SS
 COUNTY OF SEDGWICK)

I, Emil E. Bowers, do hereby certify that the above and foregoing is a true and correct copy of the copy of the log of the Curtis #1 located NE NE NE Section 36-21S-14W, Stafford County, Kansas, as reflected by the files of Bowers Drilling Company, Inc.

Emil E. Bowers

Subscribed and sworn to before me, a Notary Public in and for Sedgwick County, Kansas, this 3rd day of April, 1964.

Donna F. Miller, Notary Public

My commission expires May 1, 1966.