


WELL PLUGGING RECORD

Give All Information Completely
Make Required Affidavit
File or Deliver Report to:
Conservation Division
State Corporation Commission
800 Bittling Building
Wichita, Kansas

NORTH

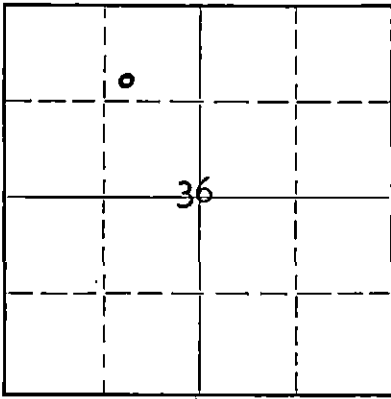

Locate well correctly on above
Section Flat

Stafford County. Sec. 36 Twp. 21 Rge. 14 (E) W(W)
Location as "NE/CNW $\frac{1}{4}$ SW $\frac{1}{4}$ " or footage from lines SW-NE-NW
Lease Owner Petroleum, Incorporated
Lease Name Keenan "D"
Office Address 100 Derby Bldg., Wichita 2, Kansas
Character of Well (completed as Oil, Gas or Dry Hole) dry hole
Date well completed January 5 1952
Application for plugging filed January 16 1952
Application for plugging approved January 27 1952
Plugging commenced January 27 1952
Plugging completed February 2 1952
Reason for abandonment of well or producing formation no producible shows
If a producing well is abandoned, date of last production --- 19
Was permission obtained from the Conservation Division or its agents before plugging was commenced? Yes

Name of Conservation Agent who supervised plugging of this well C. D. Stough
Producing formation --- Depth to top --- Bottom --- Total Depth of Well 3,826 Feet
Show depth and thickness of all water, oil and gas formations.

OIL, GAS OR WATER RECORDS

CASING RECORD

Formation	Content	From	To	Size	Put In	Pulled Out
Lansing	Water	3,556'	3,578'	8-5/8"	201'	none
Lansing	Water	3,595'	3,599'	5-1/2"	3642'	3302'

Describe in detail the manner in which the well was plugged, indicating where the mud fluid was placed and the method or methods used in introducing it into the hole. If cement or other plugs were used, state the character of same and depth placed, from --- feet to --- feet for each plug set.

(Set Baker Cast Iron Plug at 3,590'.) Filled hole with sand from 3,590' to 3,550'. Placed 5 sacks cement on top of sand at 3,550'. Filled hole with heavy mud to 200' and bridged with 15 sacks cement. Mudded up to 25' and ran 10 sacks cement filling hole.

RECEIVED
DIVISION
FEB 14 1952
Wichita, Kansas

(If additional description is necessary, use BACK of this sheet)
Correspondence regarding this well should be addressed to Petroleum, Incorporated
Address Rural Route 2, Great Bend, Kansas

STATE OF KANSAS, COUNTY OF SEDGEWICK, ss.
PAUL B. SHIVEL (employee of owner) or (~~PAUL B. SHIVEL~~) of the above-described well, being first duly sworn on oath, says: That I have knowledge of the facts, statements, and matters herein contained and the log of the above-described well as filed and that the same are true and correct. So help me God.
(Signature) Paul B. Shivel
RFD #2, Great Bend, Kansas (Address)

SUBSCRIBED AND SWORN to before me this 12th day of February, 1952

Charlotte Heidman
Notary Public.

My commission expires October 13, 1954

PLUGGING
FILE SEC 36T-21-R14W
PAGE 138 LINE 14

DRILLER'S LOG KEENAN 'D' #1

Petroleum, Inc., Lease Owner

Section 36, Twp. 21S, Rge. 14W

Garvey Drilling Co., Contractor

Location: SW NE NW

Drilling Commenced: November 28, 1951

County: Stafford

Drilling Completed: December 28, 1951

R.T.D. 3826'

Casing: 8 5/8" @ 201' w/175 sax

5 1/2" @ 3642' w/75 sax

All figures below indicate bottom of formation:

- 140 Surface soil & Sand
- 375 Shale & Shells
- 818 Red Bed & Shells
- 850 Anhydrite
- 1300 Shale & Shells
- 1465 Salt & Shells
- 1695 Shale & Lime
- 1795 Lime
- 3070 Shale & Lime
- 3125 Lime
- 3137 Shale
- 3209 Lime & Shale
- 3290 Lime
- 3402 Lime & Shale
- 3608 Lime
- 3690 Lime & Shale
- 3733 Lime
- 3745 Lime, Chert & Shale
- 3786 Shale & Lime
- 3826 Lime

Tops:

- Heebner: 3281 (-1349)
- Brown Lime: 3403 (-1471)
- Lansing: 3413 (-1481)
- Arbuckle: 3786 (-1854)

3826' R.T.D.

I hereby certify that this is a true and correct log of the above mentioned well.

PETROLEUM, INC.

STATE OF KANSAS)
COUNTY OF SEDGWICK)

RT
STATE
FEB 14 1952
GONGE DIVISION
Wichita, Kansas

By Eric H. Jager

Subscribed to and sworn to before me, a Notary Public, in said county and state this 3rd day of January, 1952.

PLUGGING

FILE SEC 36 T 27 R 26 W
BOOK PAGE 138 LINE 4

Charlotte Heidman
Notary Public

My commission expires: October 13, 1954