


STATE OF KANSAS
STATE CORPORATION COMMISSION

Give All Information Completely
Make Required Affidavit
Mail or Deliver Report to:
Conservation Division
State Corporation Commission
211 No. Broadway
Wichita, Kansas

WELL PLUGGING RECORD

NORTH

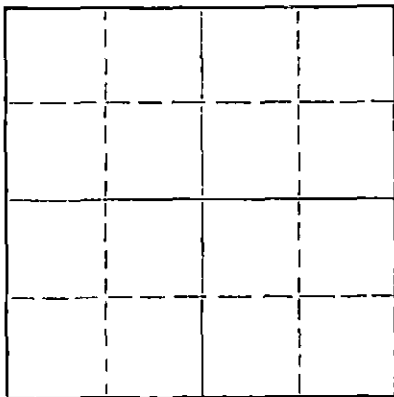

Locate well correctly on above
Section Plat

Stafford County, Sec. 21 Twp. 21 Rge. (E) 14 (W)
Location as "NE/CNW/SW" or footage from lines NW SE NE
Lease Owner Circle Oil Company, Inc.
Lease Name TITUS Well No. 1
Office Address 816 Bitting Building, Wichita, Kansas
Character of Well (completed as Oil, Gas or Dry Hole) Dry Hole
Date well completed 4/7/65 19
Application for plugging filed 19
Application for plugging approved 19
Plugging commenced 4/7/65 19
Plugging completed 4/7/65 19
Reason for abandonment of well or producing formation Dry Hole
If a producing well is abandoned, date of last production 19
Was permission obtained from the Conservation Division or its agents before plugging was commenced? Yes

Name of Conservation Agent who supervised plugging of this well _____
Producing formation _____ Depth to top _____ Bottom _____ Total Depth of Well 3777 Feet
Show depth and thickness of all water, oil and gas formations.

OIL, GAS OR WATER RECORDS

CASING RECORD

FORMATION	CONTENT	FROM	TO	SIZE	PUT IN	PULLED OUT
	8-5/8"	0	258	8-5/8"	3/31/65	
	Surface					
	Casing					

Describe in detail the manner in which the well was plugged, indicating where the mud fluid was placed and the method or methods used in introducing it into the hole. If cement or other plugs were used, state the character of same and depth placed, from _____ feet to _____ feet for each plug set.

Plug and 75 Sacks of Cement pumped in
by Halliburton.

RECEIVED
STATE CORPORATION COMMISSION

APR 14 1965

CONSERVATION DIVISION
Wichita, Kansas

(If additional description is necessary, use BACK of this sheet)
Name of Plugging Contractor Sage Drilling Co., Inc.
Address 816 Bitting Building, Wichita, Kansas

STATE OF KANSAS, COUNTY OF SEDGWICK, ss.
Thomas M. McCaul, Jr. (employee of owner) or (owner or operator) of the above-described well, being first duly sworn on oath, says: That I have knowledge of the facts, statements, and matters herein contained and the log of the above-described well as filed and that the same are true and correct. So help me God.
(Signature)

816 Bitting Bldg., Wichita, Kansas
(Address)

SUBSCRIBED AND SWORN TO before me this 12th day of April, 1965

My commission expires November 26, 1966

Louise K. Whitted
Notary Public.

DRILLERS LOGTITUS NO. 1

CASING RECORD: COMPANY: Circle Oil Co. DESCRIPTION:
 8-5/8" @ 258' CONTRACTOR: Sage Drilling Co. NW SE NE
 w/150 sax cement Sec. 21-21S-14W
 Stafford Co., Kansas
 COMMENCED: March 31, 1965
 TOTAL DEPTH: COMPLETED: April 7, 1965 ELEVATION: 1942 KB
 3777'

<u>FORMATION</u>	<u>FROM</u>	<u>TO</u>	<u>REMARKS</u>
Surface Soil	0	30	
Sand	30	195	
Shale	195	258	
Red Bed & Shale	258	858	
Anhydrite	858	879	
Shale & Shells	879	1415	
Shale & Sandy Lime	1415	1865	
Lime & Shale	1865	2040	
Lime	2040	2184	
Lime & Shale	2184	3475	
Lime	3475	3711	
Shale	3711	3777	

RECEIVED
 STATE CORPORATION COMMISSION
 APR 14 1965
 CONSERVATION DIVISION
 Wichita, Kansas

I certify that this is a true and correct copy of the above log to the best of my knowledge.

SAGE DRILLING COMPANY, INC.

Thomas M. McCaul, Jr.

Thomas M. McCaul, Jr.

Subscribed and sworn to before me this 12th day of April, 1965.

Louise K. Whitted
 Louise K. Whitted, Notary Public

My Commission expires:
 November 26, 1966.