


STATE OF KANSAS
STATE CORPORATION COMMISSION

WELL PLUGGING RECORD

Give All Information Completely
Make Required Affidavit
Mail or Deliver Report to:
Conservation Division
State Corporation Commission
212 North Market, Insurance Bldg.
Wichita, Kansas

Stafford County, Sec. 21 Twp. 21S Rge. 14 (E) (W)

Location as "NE/CNW/SW" or footage from lines NW SW NE
Lease Owner D. R. Lauck Oil Company, Inc.
Lease Name Titus Well No. 1
Office Address 301 South Broadway, Wichita, Kansas
Character of Well (completed as Oil, Gas or Dry Hole) Oil
Date well completed February 27 19 56
Application for plugging filed July 21 19 60
Application for plugging approved July 25 19 60
Plugging commenced July 31 19 60
Plugging completed August 7 19 60
Reason for abandonment of well or producing formation Depleted

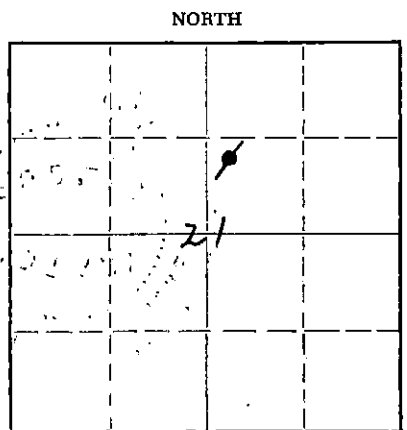

Locate well correctly on above Section Plat

If a producing well is abandoned, date of last production July 30 19 59
Was permission obtained from the Conservation Division or its agents before plugging was commenced? Yes

Name of Conservation Agent who supervised plugging of this well Mr. Frank Broadfoot
Producing formation Simpson Depth to top 3735 Bottom 3760 Total Depth of Well 3778 Feet
Show depth and thickness of all water, oil and gas formations. PB 3752

OIL, GAS OR WATER RECORDS

CASING RECORD

FORMATION	CONTENT	FROM	TO	SIZE	PUT IN	PULLED OUT
				8 5/8	862'	None
				5 1/2	3778'	2956

Describe in detail the manner in which the well was plugged, indicating where the mud fluid was placed and the method or methods used in introducing it into the hole. If cement or other plugs were used, state the character of same and depth placed, from _____ feet to _____ feet for each plug set.

Sand	3752 - 3720
5 Sx. Cement	3720 - 3690
Mud	3690 - 250
Rock Bridge	250 - 240
20 Sx. Cement	240 - 180
Mud	180 - 35
Rock & 10 Sx. Cement	35 to Cellar


RECEIVED
STATE CORPORATION COMMISSION
AUG 16 1960
CONSERVATION DIVISION
WICHITA
8-16-1960

(If additional description is necessary, use BACK of this sheet)
Name of Plugging Contractor Glenn & Smith Pipe Pulling Company
Address Box 114, Ellinwood, Kansas

STATE OF Kansas, COUNTY OF Barton, ss.
H. E. Wolfe (employee of owner) or (owner or operator) of the above-described well, being first duly sworn on oath, says: That I have knowledge of the facts, statements, and matters herein contained and the log of the above-described well as filed and that the same are true and correct. So help me God.

(Signature) [Signature]
P.O. Box 488 - 2nd Elmwood Kansas (Address)

Subscribed and sworn to before me this 12th day of August, 19 60
Catherine Hammeke Notary Public.
My commission expires April 6, 1963

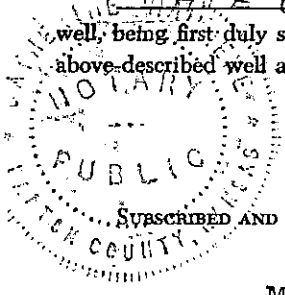

RECEIVED
STATE CORPORATION COMMISSION

JUL 28 1960

D. R. Lauck Oil Company, Inc.
& Sunray Mid-Continent Oil Company

CONSERVATION DIVISION
NW SW NE Sec. 21-21-14W White Kansas
Stafford County Kansas

#1 Titus

Commenced: February 7, 1956

Completed: February 20, 1956

Elevation: GR 1937; DF 1940; KB 1942;

Casing Record: 862' 8 5/8" cem. with 400 sacks
3778' 5 1/2" cem. with 125 sacks

Drillers Log

			<u>Tops</u>	<u>Schlumberger</u>
			<u>Sample</u>	
sand & shells	175	Anhydrite (Drillers)	858-1084	
shale	300	Heebner	3278-1336	3278-1336
sand	395	Brown Lime	3395-1453	3394-1452
red bed & shells	858	Lansing	3404-1462	3405-1463
Anhydrite	884	Base Kansas City	3641-1699	3639-1697
Red Bed & shale	935	Conglomerate	3666-1724	3666-1724
shale & shells	1720	Viola	3673-1731	3670-1728
Lime & shale	2125	Simpson shale	3715-1773	3714-1772
Lime	2225	Simpson sand	3735-1793	3733-1791
Lime & shale	3195	Arbuckle	3761-1819	3759-1817
Lime	3290	Rotary Total Depth	3778-1836	3774-1832
Lime & shale	3395			
Lime	3673			
cherty lime	3715	DST #1	3736-49	open 1 hr; strong steady
shale	3720			blow 1 hour.
Lime & sand	3749			recovered 700' gas on top
shale	3761			of 1040 ft of gassy oil;
Lime	3778			IFP-o# FFP 330#
RTD	3778			BHP 420# in 20 min.