

plugged 11-15-87

STATE CORPORATION COMMISSION OF KANSAS
OIL & GAS CONSERVATION DIVISION
WELL COMPLETION OR RECOMPLETION FORM
ACO-1 WELL HISTORY
DESCRIPTION OF WELL AND LEASE

7383

Operator: License #
Name GRADY BOLDING CORPORATION
Address P. O. Box 244
City/State/Zip Great Bend, Kans. 67530

Purchaser.....

Operator Contact Person Grady Bolding
Phone (316) 564-2240

Contractor: License # 6039
Name L. D. Drilling, Inc.

Wellsite Geologist Rod Tremblay
Phone (913) 625-5434

Designate Type of Completion
New Well Re-Entry Workover
Oil SWD Temp Abd
Gas Inj Delayed Comp.
 Dry Other (Core, Water Supply etc.)

If OWWO: old well info as follows:
Operator
Well Name
Comp. Date Old Total Depth.....

WELL HISTORY

Drilling Method:
 Mud Rotary Air Rotary Cable

11-6-87 11-15-87 11-15-87
Spud Date Date Reached TD Completion Date

4731'
Total Depth PBTD

Amount of Surface Pipe Set and Cemented at 428 feet
Multiple Stage Cementing Collar Used? Yes No
If yes, show depth set.....feet
If alternate 2 completion, cement circulated
from.....feet depth to.....w/.....SX cmt
Cement Company Name
Invoice #

API NO. 15-055-20,753.0000
County Finney
SW SW SW 5 21 33 East
..... Sec. Twp. Rge. West

330 Ft North from Southeast Corner of Section
4950 Ft West from Southeast Corner of Section
(Note: Locate well in section plat below)


Lease Name Campbell "A" Well # 1

Field Name.....

Producing Formation.....

Elevation: Ground 2921 KB 2926

Section Plat

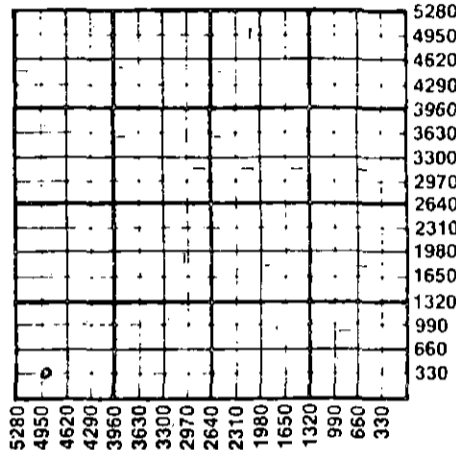

WATER SUPPLY INFORMATION

Disposition of Produced Water: Disposal
Docket # Repressuring

Questions on this portion of the ACO-1 call:
Water Resources Board (913) 296-3717

Source of Water:
Division of Water Resources Permit #.....

Groundwater.....Ft North from Southeast Corner
(Well)Ft West from Southeast Corner of
Sec Twp Rge East West

Surface Water.....Ft North from Southeast Corner
(Stream, pond etc).....Ft West from Southeast Corner
Sec Twp Rge East West

Other (explain) hauled water
(purchased from city, R.W.D. #)

INSTRUCTIONS: This form shall be completed in triplicate and filed with the Kansas Corporation Commission, 200 Colorado Derby Building, Wichita, Kansas 67202, within 120 days of the spud date of any well. Rule 82-3-130, 82-3-107 and 82-3-106 apply.

Information on side two of this form will be held confidential for a period of 12 months if requested in writing and submitted with the form. See rule 82-3-107 for confidentiality in excess of 12 months. One copy of all wireline logs and drillers time log shall be attached with this form. Submit CP-4 form with all plugged wells. Submit CP-111 form with all temporarily abandoned wells.

All requirements of the statutes, rules and regulations promulgated to regulate the oil and gas industry have been fully complied with and the statements herein are complete and correct to the best of my knowledge.

Signature *Grady Bolding*
Title *President* Date 11-20-87

Subscribed and sworn to before me this 20th day of November 1987
Notary Public *Jenny Kasselmann*
Date Commission Expires 7-16-90

K.C.C. OFFICE USE ONLY
F Letter of Confidentiality Attached
C Wireline Log Received
C Drillers Timelog Received
Distribution
 KCC SWD/Rap NGPA
 KGS Plug Other
(Specify)

Sec 5, Twp. 21 N, Rge. 33 E

JENNY KASSELMAN
NOTARY PUBLIC
STATE OF KANSAS
MY APPT. EXPIRES 7-16-90

11-23-1987

SIDE TWO

Operator Name GRADY BOLDING CORPORATION Lease Name..... Campbell "A" Well #..... 1.....

Sec..... 5 Twp..... 21S Rge..... 33 East West County..... Finney

WELL LOG

INSTRUCTIONS: Show important tops and base of formations penetrated. Detail all cores. Report all drill stem tests giving interval tested, time tool open and closed, flowing and shut-in pressures, whether shut-in pressure reached static level, hydrostatic pressures, bottom hole temperature, fluid recovery, and flow rates if gas to surface during test. Attach extra sheet if more space is needed. Attach copy of log.

Drill Stem Tests Taken Yes No
 Samples Sent to Geological Survey Yes No
 Cores Taken Yes No

Formation Description
 Log Sample

DST#1 - 4614-4650'

Recovery - 10' Drilling Mud
 Pressures: ISIP-FSIP ; 91# - 83#
 IFP - 66# - 66# IHP-2432#
 FFP - 66# - 75# FHP-2416#
 Times - 30-30-30-30

Name	Top	Bottom
Heebner	3818'	
Lansing/KC	3860'	
Base KC	4310'	
Marmaton	4328'	
FT. Scott	4434'	
Cherokee Sand	4454'	
Morrow Shale	4616'	
Mississippi	4690'	
Log T. D.	4732'	

DST#2 - 4657-4680'

Misrun - Packer Failure

CASING RECORD <input checked="" type="checkbox"/> New <input type="checkbox"/> Used							
Report all strings set-conductor, surface, intermediate, production, etc.							
Purpose of String	Size Hole Drilled	Size Casing Set (in O.D.)	Weight Lbs/Ft.	Setting Depth	Type of Cement	#Sacks Used	Type and Percent Additives
Surface	7-7/8"	8-5/8"	23#	428'	60-40 Poz.	300	2% Gel; 3% CC
PERFORATION RECORD				Acid, Fracture, Shot, Cement Squeeze Record			
Shots Per Foot	Specify Footage of Each Interval Perforated			(Amount and Kind of Material Used)		Depth	
TUBING RECORD				Liner Run <input type="checkbox"/> Yes <input type="checkbox"/> No			
Size	Set At	Packer at					
Date of First Production	Producing Method						
	<input type="checkbox"/> Flowing <input type="checkbox"/> Pumping <input type="checkbox"/> Gas Lift <input type="checkbox"/> Other (explain).....						
Estimated Production Per 24 Hours	Oil	Gas	Water	Gas-Oil Ratio	Gravity		
	Bbls	MCF	Bbls	CFPB			

METHOD OF COMPLETION

Production Interval

Disposition of gas: Vented Open Hole Perforation
 Sold Other (Specify)
 Used on Lease Dually Completed
 Conmingled