


STATE OF KANSAS  
STATE CORPORATION COMMISSION

Give All Information Completely  
Make Required Affidavit  
Mail or Deliver Report to:  
Conservation Division  
State Corporation Commission  
P. O. Box 17027  
Wichita, Kansas 67217  
NORTH

WELL PLUGGING RECORD

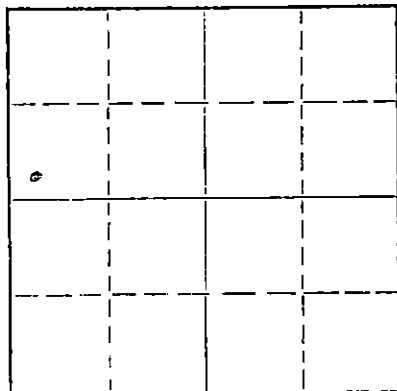

Locate well correctly on above  
Section Plat

Stafford County, Sec. 14 Twp. 21 Rge. (E) 11 (W)  
Location as "NE/CNW/SW" or footage from lines SW SW NW  
Lease Owner F. G. Holl  
Lease Name Fair "C" Well No. 1  
Office Address 6427 E. Kellogg, Wichita, Kansas 67207  
Character of Well (completed as Oil, Gas or Dry Hole) oil  
Date well completed 19  
Application for plugging filed May 21 19 73  
Application for plugging approved 19  
Plugging commenced May 21 19 73  
Plugging completed June 5 19 73  
Reason for abandonment of well or producing formation depleted

If a producing well is abandoned, date of last production 19  
Was permission obtained from the Conservation Division or its agents before plugging was commenced? yes

Name of Conservation Agent who supervised plugging of this well G. R. Biberstein  
Producing formation \_\_\_\_\_ Depth to top \_\_\_\_\_ Bottom \_\_\_\_\_ Total Depth of Well 3415 Feet  
Show depth and thickness of all water, oil and gas formations.

OIL, GAS OR WATER RECORDS

CASING RECORD

FORMATION	CONTENT	FROM	TO	SIZE	PUT IN	PULLED OUT
		0	248'	8 5/8"	248'	none
			3415'	5 1/2"	3415'	2628.76

Describe in detail the manner in which the well was plugged, indicating where the mud fluid was placed and the method or methods used in introducing it into the hole. If cement or other plugs were used, state the character of same and depth placed, from \_\_\_\_\_ feet to \_\_\_\_\_ feet for each plug set.

Sanded back to 3080' and dumped 5 sacks of cement.

Plugged well with 2 sacks of hulls, 15 sacks of gel and 100 sacks of cement.

RECEIVED  
STATE CORPORATION COMMISSION  
JUN 12 1973  
CONSERVATION DIVISION  
Wichita, Kansas

Name of Plugging Contractor PIPE PULLERS, INC.  
Address Box 486, Ellinwood, Kansas 67526

STATE OF KANSAS, COUNTY OF BARTON, ss.  
Evelyn Roth (employee of owner) or (owner or operator) of the above-described well, being first duly sworn on oath, says: That I have knowledge of the facts, statements, and matters herein contained and the log of the above-described well as filed and that the same are true and correct. So help me God.

(Signature) Evelyn Roth  
Ellinwood, Kansas (Address)

SUBSCRIBED AND SWORN to before me this 11th day of June, 1973.  
George A. Meyer Notary Public.

My commission expires Feb. 10, 1975

RECEIVED  
STATE CORPORATION COMMISSION

MAY 23 1973

CONSERVATION DIVISION  
Wichita, Kansas

## Well Log

DATE COMMENCED: July 19, 1968  
DATE COMPLETED: July 26, 1968F. G. Holl  
FAIR C-1  
SW/4 SW/4 NW/4  
Section 14-T21s-R11w  
Stafford County, Kansas

ELEVATION: 1743 K.B.

0	-	172'	Sand
172	-	454'	Red Bed
454	-	475'	Anhydrite
475	-	1305'	Shale - Shells
1305	-	1979'	Lime w/shale
1979	-	2748'	Shale & Lime
2748	-	2919'	Lime
2919	-	2925'	Shale
2925	-	2950'	Lime & Shale
2950	-	3048'	Shale
3048	-	3067'	Lime
3067	-	3312'	Lime - Shale
3312	-	3332'	Lime & Chert
3332	-	3386'	Chert - conglomerate
3386	-	3408'	Shale - Sand
3408	-	3415'	Dolomite

FORMATION DATA

Anhydrite	454'
Heebner	2919'
Douglas	2950'
Brown Lime	3048'
Kansas City	3067'
B. Kansas City	3312'
Cherty Congl.	3332'
Simp. Shale	3386'
Arbuckle	3408'
R.T.D.	3415'

Surface Casing: Set 248' of  
8-5/8" with 225 sacks cement.Production Casing: Set used  
5 1/2" casing at 3415'


## A F F I D A V I T

STATE OF KANSAS, COUNTY OF BARTON ) ss.

Lynn O. Duke, of lawful age, does swear and state that the facts and statements herein contained are true and correct to the best of his knowledge.


Subscribed and sworn to before me this 2nd day of August, 1968.

My Comm. Expires:

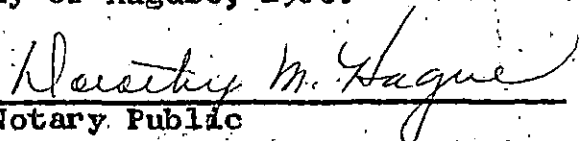April 11, 1970


Notary Public