


STATE OF KANSAS  
STATE CORPORATION COMMISSION

Give All Information Completely  
Make Required Affidavit  
Mail or Deliver Report to:  
Conservation Division  
State Corporation Commission  
800 Bitting Building  
Wichita, Kansas

WELL PLUGGING RECORD

Stafford County. Sec. 6 Twp. 21 Rge. (E) 13 (W)

Location as "NE/CNWxSWx" or footage from lines SW NW NE  
Lease Owner Westgate-Greenland Oil Company  
Lease Name Wayne L. Morrison Well No. 3  
Office Address 1009 Central Building  
Character of Well (completed as Oil, Gas or Dry Hole) dry hole  
Date well completed March 26, 1963 19  
Application for plugging filed March 26, 1953 (orally) 19  
Application for plugging approved March 26, 1953 19  
Plugging commenced March 26, 1953 19  
Plugging completed March 27, 1953 AM 2 o'clock 19  
Reason for abandonment of well or producing formation

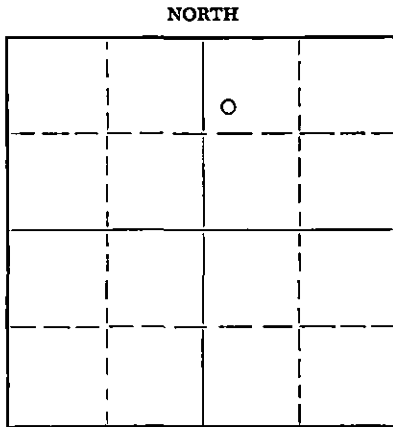

Locate well correctly on above  
Section Plat

If a producing well is abandoned, date of last production 19  
Was permission obtained from the Conservation Division or its agents before plugging was commenced? yes

Name of Conservation Agent who supervised plugging of this well  
Producing formation Depth to top Bottom Total Depth of Well Feet  
Show depth and thickness of all water, oil and gas formations.

OIL, GAS OR WATER RECORDS

CASING RECORD

FORMATION	CONTENT	FROM	TO	SIZE	PUT IN	PULLED OUT
Surface		0	241	10 3/4	241	none

Describe in detail the manner in which the well was plugged, indicating where the mud fluid was placed and the method or methods used in introducing it into the hole. If cement or other plugs were used, state the character of same and depth placed, from feet to feet for each plug set.

Filled hole with heavy mud from T.D. to 240 feet  
Set plug and ran 20 sacks cement at 240 feet to 200 Feet  
Filled with heavy mud from 200 to 35 feet  
Set plug at 35 feet and ran 10 sacks cement to cellar.

(If additional description is necessary, use BACK of this sheet)

Name of Plugging Contractor Westgate Drilling Corporation  
Address 1009 Central Building, Wichita 2, Kansas

STATE OF Kansas, COUNTY OF Sedgwick, ss.  
G. E. Bitler (employee of owner) or (owner or operator) of the above-described well, being first duly sworn on oath, says: That I have knowledge of the facts, statements, and matters herein contained and the log of the above-described well as filed and that the same are true and correct. So help me God.

(Signature) G. E. Bitler  
1009 Central Bldg, Wichita, Kansas  
(Address)

SUBSCRIBED AND SWORN TO before me this 30th day of March 19 53

My commission expires May 25, 1953.

Notary Public.

24-2675-S

2-52-20M

RECEIVED  
STATE CORPORATION COMMISSION  
MAR 31 1953  
CONSERVATION DIVISION  
Wichita, Kansas

3-31-1953

PLUGGING  
FILE SEC. 6 T 21 R 13 W  
BOOK PAGE 87 LINE 42

COMPANY: Westgate-Greenland Oil Company  
 CONTRACTOR: Westgate Drilling Corporation  
 FARM: Wayne L. Morrison #3  
 SW NW NE Sec 6-21S-13W, Stafford County  
 COMMENCED: March 13, 1953  
 COMPLETED: March 27, 1953  
 ELEVATION: 1912 DF

0	to	40	Soil and sand
40	to	170	Sand
170	to	210	Sand and Clay
210	to	225	Sand and shale
225	to	255	Shale and shells
255	to	325	Sand and shale
325	to	355	Shale and shells
355	to	585	Red bed and shale
585	to	798	Red bed
798	to	831	Anhydrite
831	to	1130	Shale and shells
1130	to	1330	Shale and lime W/salt
1330	to	1550	Shale and shells
1550	to	1735	Shale and lime
1735	to	1930	Lime
1930	to	3040	Lime and shale
3040	to	3206	Lime
3206	to	3243	Lime W/shale breaks
3243	to	3317	Lime Shale and sandy shale
3317	to	3335	Lime and shale
3335	to	3537	Lime
3537	to	3571	Shale, lime and sand
3571	to	3598	Simpson shale W/sand
3598	to	3601	Shale and sand
3601	to	3650	Arbuckle lime
		3650	T. D. RB

Set 241 feet of 10 3/4" Surface pipe. Cemented with 200 sacks cement and 3 sacks calcium chloride.

TOPS: Anhydrite 796 Brown Lime 3313 Base K C 3527  
 Heebner 3197 Lansing 3324 Arbuckle 3598

Drill Stem Tests:

- 3596-3605, open 1 hr, Shut in 25 min, weak blow, recovered 105 feet mud, BHP 1210#.
- 3600-12, weak intermittent blow, rec. 50 feet drilling mud.
- 3613-19, open 1 hour, weak blow 47 minutes, rec. 30 feet drilling mud, BHP 1070#.
- 3616-26, open 1 hour, weak intermittent blow, rec 35 feet muddy salt water, 960# BHP.

Schlumberger run

DRY, BPLUGGED AND ABANDONED

C E R T I F I C A T E

I, G. E. Bitler, do hereby certify that the above and foregoing is a true and correct copy of the log of the Wayne L. Morrison #3, SW NW NE Section 6-21S13 W, Stafford County, Kansas, as reflected by files of the Westgate-Greenland Oil Company.

*G. E. Bitler*  
 G. E. Bitler

Subscribed and sworn to before me, a Notary Public, within and for Sedgwick County, Kansas, this 30th day of March, 1953.

*Esther Russell*

My commission expires May 25, 1953.

RECEIVED  
 STATE CORPORATION COMMISSION  
 MAR 31 1953  
 CONSERVATION DIVISION  
 Wichita, Kansas

PLUGGING  
 FILE SEC. 6 T 21 R 13 W  
 BOOK PAGE 87 LINE 42