

# WELL PLUGGING RECORD

STATE OF KANSAS  
STATE CORPORATION COMMISSION

Give All Information Completely  
Make Required Affidavit  
Mail or Deliver Report to:  
Conservation Division  
State Corporation Commission  
800 Bittling Building  
Wichita, Kansas

## FORMATION PLUGGING RECORD

Strike out upper line  
when reporting plug-  
ging off formations.

Stafford County. Sec. 6 Twp. 21S Rge. ~~13~~ 13 (W)

Location as "NE $\frac{1}{4}$ NW $\frac{1}{4}$ SW $\frac{1}{4}$ " or footage from lines C-W/2 SW SE

Lease Owner Sunray Oil Corporation

Lease Name E. E. Morrison Well No. 1

Office Address Box 195, Great Bend, Kansas

Character of Well (completed as Oil, Gas or Dry Hole) Dry Hole

Date well completed 1/14 19 51

Application for plugging filed 1/15 19 51

Application for plugging approved 1/17 19 51


Plugging commenced 2/7 19 51

Plugging completed 2/17 19 51

Reason for abandonment of well or producing formation Produced only water

If a producing well is abandoned, date of last production none 19

Was permission obtained from the Conservation Division or its agents before plugging was commenced? Yes

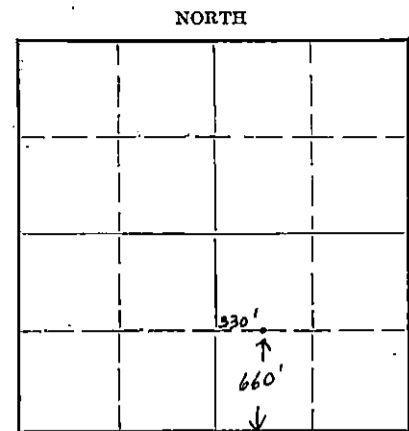

Locate well correctly on above Section Plat

Name of Conservation Agent who supervised plugging of this well C. D. Stough

Producing formation Arbuckle Depth to top 3616 Bottom 3620 Total Depth of Well 3620 Feet

Show depth and thickness of all water, oil and gas formations.

### OIL, GAS OR WATER RECORDS

### CASING RECORD

Formation	Content	From	To	Size	Put In	Pulled Out
Lansing-KC	Water	3332	3556	8-5/8"	810'	none
Arbuckle	Water	3616	3620	5 1/2"	3616 1/2'	2127.17'

Describe in detail the manner in which the well was plugged, indicating where the mud fluid was placed and the method or methods used in introducing it into the hole. If cement or other plugs were used, state the character of same and depth placed, from feet to feet for each plug set.

Hole was plugged back from TD of 3620' with crushed rock to 3600'. Dumped 5 sax of cement with bailer, top of cement plug 3560'. Filled hole with heavy mud to 250'. Set rock bridge and dumped 15 sax of cement. Filled hole with mud from 250'-30'. Mixed 10 sax of cement for cap on well.

Plugged by Forbes Casing Pulling Co.

**RECEIVED**  
STATE CORPORATION COMMISSION  
FEB 27 1951  
CONSERVATION DIVISION  
Wichita, Kansas

(If additional description is necessary, use BACK of this sheet)

Correspondence regarding this well should be addressed to Sunray Oil Corporation  
Address Box 195, Great Bend, Kansas

STATE OF KANSAS, COUNTY OF BARTON, ss.  
Earl H. Ramsey (employee of owner) or (owner or operator) of the above-described well,

being first duly sworn on oath, says: That I have knowledge of the facts, statements, and matters herein contained and the log of the above-described well as filed and that the same are true and correct. So help me God.

(Signature) *Earl H. Ramsey* Geologist

Box 195, Great Bend, Kansas  
(Address)

SUBSCRIBED AND SWORN to before me this 26th day of February, 1951

*Maucha Scott*  
Notary Public.

My commission expires April 19, 1952.

22-2625 2-48-15M  
**PLUGGING**  
FILE SEC 6 T 21 R 32  
BOOK PAGE 55 LINE 37

*State Corp.*

Morrison #1 Well

Sec. 6-21S-13W, Stafford County, Kansas

Drilled for: Sunray Oil Corporation

Drilled by: Mouser Drilling Company

Drilling Commenced: November 23, 1950

Drilling Completed: December 9, 1950

Casing Record:

8 5/8" 810' 8 rd thd 2 1/2" Casing  
 5 1/2" 3616 1/2' 8 rd thd 1 1/2" Casing

<u>FORMATION</u>	<u>DEPTH</u>	<u>FORMATION</u>	<u>DEPTH</u>
Collar	5	Lime	3112
Surface clay and sand	130	Shale and lime	3195
Clay and sand	260	Lime and shale	3297
Grey shale	300	Shale	3320
Sand	340	Lime	3542
Red Bed	570	Shale	3616
Shale and shells	750	Arbuckle	3618
Red Bed	793		
Anhydrite	825		
Red bed	950	Total Depth	3618'
Shale and shells	1185		
Salt	1400		
Shale and shells	1615		
Lime	1735		
Lime and shale	1835		
Sandy Lime	1900		
Shale and lime	1925		
Lime	2025		
Lime and shale	2110		
Shale and lime	2355		
Shale and shells	2465		
Shale	2570		
Shale and lime	2700		
Lime and shale	2730		
Shale and lime	2840		
Lime	2915		
Lime and shale	2930		
Lime	2984		
Broken Lime	3030		

**RECEIVED**  
 STATE CORPORATION COMMISSION  
 FEB 27 1951  
 CONSERVATION DIVISION  
 Wichita, Kansas

STATE OF KANSAS )  
 ) SS  
 COUNTY OF SEDGWICK)

I, the undersigned, being duly sworn on oath, state that the above and within statement is a true and correct record and log of the well drilled on the above described location to the best of my knowledge and belief.

*B. L. Mouser*

Subscribed and sworn to before me this 19th day of December 1950.

My Commission Expires:

March 18 1951

**PLUGGING**  
 FILE SEC LT 21 R 13W  
 BOOK PAGE 55 LINE 37

*Francis L. Hubbel*