


STATE OF KANSAS  
STATE CORPORATION COMMISSION

Give All Information Completely  
Make Required Affidavit  
Mail or Deliver Report to:  
Conservation Division  
State Corporation Commission  
800 Bitting Building  
Wichita, Kansas

WELL PLUGGING RECORD

Stafford County. Sec. 6 Twp. 21 Rge. 13 (W)

Location as "NE/CNW/SW" or footage from lines NE SE NE  
Lease Owner Westgate-Greenland Oil Company  
Lease Name Wayne L. Morrison Well No. 4  
Office Address 1009 Central Building, Wichita 2, Kansas  
Character of Well (completed as Oil, Gas or Dry Hole) dry hole  
Date well completed May 9, 1953 19  
Application for plugging filed (orally) May 9, 1953 19  
Application for plugging approved Written- May 11, 1953 19  
Plugging commenced May 9, 1953 19  
Plugging completed May 9, 1953 19  
Reason for abandonment of well or producing formation \_\_\_\_\_

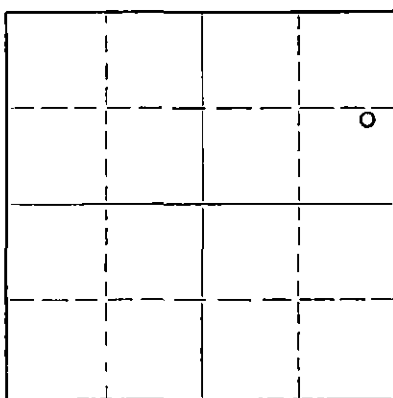

Locate well correctly on above  
Section Plat

If a producing well is abandoned, date of last production \_\_\_\_\_ 19  
Was permission obtained from the Conservation Division or its agents before plugging was commenced? yes

Name of Conservation Agent who supervised plugging of this well M. A. Rives  
Producing formation \_\_\_\_\_ Depth to top \_\_\_\_\_ Bottom \_\_\_\_\_ Total Depth of Well \_\_\_\_\_ Feet  
Show depth and thickness of all water, oil and gas formations.

OIL, GAS OR WATER RECORDS

CASING RECORD

FORMATION	CONTENT	FROM	TO	SIZE	PUT IN	PULLED OUT
Surface		0	218	10 3/4"	218	none

Describe in detail the manner in which the well was plugged, indicating where the mud fluid was placed and the method or methods used in introducing it into the hole. If cement or other plugs were used, state the character of same and depth placed, from \_\_\_\_\_ feet to \_\_\_\_\_ feet for each plug set.

Filled hole with heavy mud from 3670 to 210 feet  
Set plug at 210' and ran 20 sacks cement to 170 feet  
Filled with heavy mud from 170 to 40 feet,  
Set plug and ran 10 sacks cement to cellar.

5-14-1953

(If additional description is necessary, use BACK of this sheet)

Name of Plugging Contractor Westgate Drilling Corporation  
Address 1009 Central Building, Wichita 2, Kansas

STATE OF Kansas, COUNTY OF Sedgwick, ss.  
G. E. Bitler (employee of owner) ~~XXXXXXXXXXXX~~ of the above-described well, being first duly sworn on oath, says: That I have knowledge of the facts, statements, and matters herein contained and the log of the above-described well as filed and that the same are true and correct. So help me God.

(Signature) G. E. Bitler  
1009 Central Building, Wichita 2, Kansas  
(Address)

SUBSCRIBED AND SWORN TO before me this 14th day of May, 19 53

Esther J. Well  
Notary Public.

My commission expires May 25, 1953.

**PLUGGING**  
 FILE SEC 6 T 21 R 13W  
 BOOK 100 PAGE 17

DRILLER'S LOG

COMPANY: Westgate-Greenland Oil Company  
 CONTRACTOR: Westgate Drilling Corporation  
 FARM: Wayne L. Morrison #4, NE SE NE  
 Sec. 6-21S-13W, Stafford County, Kansas  
 COMMENCED: April 29, 1953  
 COMPLETED: May 9, 1953  
 ELEVATION: 1905 DF

0	to	198	Sand and clay
198	to	330	Shale and shells
330	to	790	Red bed and shells
790	to	825	Anhydrite
825	to	1000	Shale, shells, sand and red bed
1000	to	1230	Shale and shells
1230	to	1450	Sale, shale & shells
1450	to	1500	Shale and shells
1500	to	1650	Shale and lime
1650	to	1700	Lime
1700	to	1940	Lime and shale
1940	to	2015	Lime
2015	to	2350	Lime and shale
2350	to	2545	Shale and shells
2545	to	2620	Shale
2620	to	2835	Shale and lime
2835	to	3180	Lime
3180	to	3324	Shale and lime
3324	to	3520	Lime
3520	to	3580	Lime and shale
3580	to	3595	Lime, cherty-Viola
3595	to	3610	Lime
3610	to	3630	Lime (cherty)
3630	to	3650	Lime, shale and sand
3650	to	3670	Shale and chert
		3670	T. D. (RB)

Set 218' of 10 3/4" 32.75# surface pipe.  
 Cemented with 225 sacks cement(Posmix) 3 sacks calcium chloride. Recemented with 125 sacks regular cement and 2 sacks calcium chloride.

TOPS: Anhydrite	788	Brown Lime	3310	Base Kansas City	3536
Heebner	3195	Lansing	3322	Viola	3576
				Simpson	3627
				(no Arbuckle)	

No drill stems. No Schlumberger.  
 DRY, PLUGGED and ABANDONED

C E R T I F I C A T E

I, Harold A. Burt, do hereby certify that the above and foregoing is a true and correct copy of the log of the Wayne L. Morrison #4, NE SE NE Section 6-21S-13W, Stafford County, Kansas, as reflected by files of the Westgate-Greenland Oil Company.

*Harold A. Burt*  
 Harold A. Burt

Subscribed and sworn to before me, a Notary Public, within and for Sedgwick County, Kansas, this 13th day of May, 1953.

RECEIVED STATE CORPORATION COMMISSION  
 ESTHER UNSSELL  
 Esther Unsell, Notary Public

My commission expires May 25, 1953.  
 MAY 14 1953

CONSERVATION DIVISION  
 Wichita, Kansas

PLUGGING  
 FILE SEC 6 T 21 R 13W  
 BOOK PAGE 100 LINE 17