


WELL PLUGGING RECORD

Give All Information Completely
Make Required Affidavit
Mail or Deliver Report to:
Conservation Division
State Corporation Commission
800 Bittling Building
Wichita, Kansas

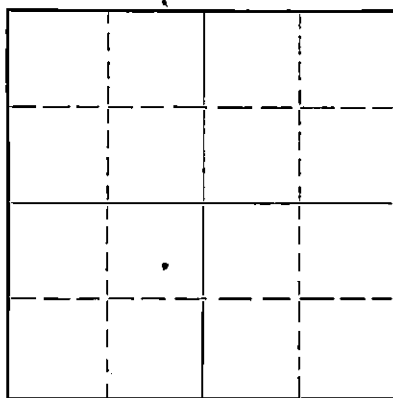

Locate well correctly on above Section Plat

Stafford County. Sec. 6 Twp. 21 Rge. 13 (E) ~~(W)~~
 Location as "NE/CNW $\frac{1}{4}$ SW $\frac{1}{4}$ " or footage from lines SE NE SW
 Lease Owner BEN F. BRACK OIL COMPANY, INC.
 Lease Name Parish Well No. 1
 Office Address 309 Brown Building, Wichita, Kansas
 Character of Well (completed as Oil, Gas or Dry Hole) Dry Hole
 Date well completed 12/31/50 19
 Application for plugging filed 12/31/50 19
 Application for plugging approved 12/31/50 19
 Plugging commenced 12/31/50 19
 Plugging completed 12/31/50 19
 Reason for abandonment of well or producing formation nothing there

If a producing well is abandoned, date of last production 19
 Was permission obtained from the Conservation Division or its agents before plugging was commenced? Yes

Name of Conservation Agent who supervised plugging of this well Mr. C. D. Stough
 Producing formation Arbuckle Depth to top Bottom Total Depth of Well 3628 Feet
 Show depth and thickness of all water, oil and gas formations.

OIL, GAS OR WATER RECORDS

CASING RECORD

Formation	Content	From	To	Size	Put In	Pulled Out
Clay, Sand, Sahle, and Shells	no show	1	283	8 5/8"	283'	
Arbuckle	no show	3625	3628	-- --	-- --	-- --

Describe in detail the manner in which the well was plugged, indicating where the mud fluid was placed and the method or methods used in introducing it into the hole. If cement or other plugs were used, state the character of same and depth placed, from 280' feet to 35' feet for each plug set.

Filled with mud -
 First plug set at 280' and cemented with 15 sacks cement.
 Top plug set at 35' and cemented with 10 sacks of cement.
 Filled and leveled hole.

1-11-1951
 RECEIVED
 STATE CORPORATION COMMISSION
 JAN 11 1951
 CONSERVATION DIVISION
 Wichita, Kansas

(If additional description is necessary, use BACK of this sheet)

Correspondence regarding this well should be addressed to BEN F. BRACK OIL COMPANY, INC.
 Address 309 Brown Building, Wichita 2, Kansas

STATE OF KANSAS, COUNTY OF SEDEGWICK, ss.
 Emil E. Bowers (employee of owner) or (owner or operator) of the above-described well,
 being first duly sworn on oath, says: That I have knowledge of the facts, statements, and matters herein contained and the log of the above-described well as filed and that the same are true and correct. So help me God.

(Signature) *Emil E. Bowers*
 BEN F. BRACK OIL COMPANY, INC.
 309 Brown Building Wichita 2, Kansas
 (Address)

SUBSCRIBED AND SWORN to before me this 10th day of January, 1951

Ullis R. Evans
 Notary Public.

My commission expires November 1, 1951

PLUGGING
 FILE SEC 6 T 21 R 13
 BOX PAGE 52 LINE 6

BEN F. BRACK OIL COMPANY, INC.
309-10 Brown Building
Wichita 2, Kansas

PARISH #1

SE NE SW Sec 6 Twp 21 Rg 13E
Stafford County, Kansas

Commenced: December 14, 1950

Completed: Dec. 31, 1950
Elevation: 1911

TOTAL DEPTH: 3628

WELL LOG

Cellar	5'
Clay, Sand	40
Shale, Shells	225
Sand and Red Bed	525
Red Bed and Shale	800
Anhydrite	840
Red Bed and Shale	1142
Shale-Shells	1365
Salt Shale	1550
Shale, Shells	1580
Shale, Broken Lime	1745
Shale and Shells	1820
Lime and Shells	1875
Shale, Lime	1975
Lime and Shale	3080
Broken Lime and Shale	3140
Lime	3192
Lime and Shale	3350
Lime	3590
Lime and Shale	3628

CASING RECORD

8 5/8" 283'

FORMATIONS

Heebner	3210
Brown Lime	3326
Lansing	3338
Viola	3562
Simpson	3574
Arbuckle	3625

To the best of my knowledge, the above is a correct and true statement of all formations and where found.

BEN F. BRACK OIL COMPANY, INC.

By

Emil E. Bowers

WITNESSED:

Velda R. Evans

January 10, 1951

PLUGGING
FILE SEC 6T-21-R(3a)
BOOK PAGE 53 LINE 6

RECEIVED
REGISTRATION COMMISSION
JAN 11 1951
CONSERVATION DIVISION
Wichita, Kansas