


WELL PLUGGING RECORD

Give All Information Completely
Make Required Affidavit
Mail or Deliver Report to:
Conservation Division
State Corporation Commission
800 Bittling Building
Wichita, Kansas

NORTH

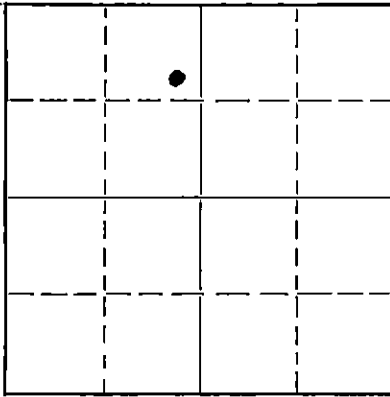

Locate well correctly on above Section Plat

Stafford County, Sec. 6 Twp. 21 S. Rge. 13 (E) W (W)
Location as "NE/CNW $\frac{1}{4}$ /SW $\frac{1}{4}$ " or footage from lines SE-NE-NW
Lease Owner PETROLEUM, Inc.
Lease Name Parrish Well No. 1
Office Address 305 East Third Street, Wichita, Kansas
Character of Well (completed as Oil, Gas or Dry Hole) Oil
Date well completed March 12 19 53
Application for plugging filed May 23 19 53
Application for plugging approved May 26 19 53
Plugging commenced May 26 19 53
Plugging completed June 1 19 53
Reason for abandonment of well or producing formation Depleted producible zones.
If a producing well is abandoned, date of last production May 21 19 53
Was permission obtained from the Conservation Division or its agents before plugging was commenced? Yes

Name of Conservation Agent who supervised plugging of this well M. A. Rives
Producing formation Arbuckle Depth to top 3,572' Bottom ----- Total Depth of Well 3,625' Feet
Show depth and thickness of all water, oil and gas formations.

OIL, GAS OR WATER RECORDS

CASING RECORD

Formation	Content	From	To	Size	Put In	Pulled Out
Arbuckle	Oil & Water	3,573'	3,577'	8-5/8"	219'	None
Arubckle	Water	3,581'	3,599'	5-1/2"	3,624'	3,022'

Describe in detail the manner in which the well was plugged, indicating where the mud fluid was placed and the method or methods used in introducing it into the hole. If cement or other plugs were used, state the character of same and depth placed, from ----- feet to ----- feet for each plug set.

(Plugged back to 3,577.5')

Filled hole from 3,577.5' to 3,560' with crushed rock and placed cement from 3,560' to 3,520'. Mudded up to 219' and set rock bridge. Filled hole with cement to 140'. Mudded up to 35' and filled hole to surface with cement.

(If additional description is necessary, use BACK of this sheet)

Correspondence regarding this well should be addressed to PETROLEUM, Inc.
Address Rural Route 2, Great Bend, Kansas

STATE OF Kansas, COUNTY OF Sedgewick, ss.
C. J. Wiltse (employee of owner) or (owner or operator) of the above-described well, being first duly sworn on oath, says: That I have knowledge of the facts, statements, and matters herein contained and the log of the above-described well as filed and that the same are true and correct. So help me God.

(Signature) *C. J. Wiltse*
Rural Route 2, Great Bend, Kansas
(Address)

SUBSCRIBED AND SWORN to before me this 5th day of June, 19 53

My Commission Expires Oct. 13, 1954

My commission expires

22-7877-8

4-40-10M

PLUGGING
FILE SEC 6 T 21 R 130
BOOK PAGE 103 LINE 32

RECEIVED
JUN 16 1953
6-16-1953
Notary Public

DRILLER'S LOG PARISH NO. 1

Petroleum, Inc., Operator	Section 6, Twp. 21S., Rge. 13W
Garvey Drilling Company, Contractor	Location: SE NE NW
Drilling Commenced: February 22, 1953	County: Stafford County, Kansas
Drilling Completed: March 4, 1953	R.T.D.: 3625'
Casing Record: 8 5/8" @ 219' w/175' sax 5 1/2" @ 3624'	Production: Arbuckle

Figures below indicate bottom of formation

40	Surface soil	
205	Sand	
219	Shale	
340	Sand & Shale	Heebner: 3188 (-1274)
810	Red Bed	Brown Lime: 3305 (-1391)
839	Anhydrite	Lansing: 3316 (-1402)
1675	Shale & Shells	Arbuckle: 3572 (-1658)
2940	Lime & Shale	
3190	Lime	DST, 3573-78, open 1 hour, rec. 420'
3305	Lime & Shale	oil, 1000# BHP.
3555	Lime	
3572	Lime & Shale	
3625	Lime	
3625'	R.T.D.	

I hereby certify that this is a true and correct log of the above mentioned well.

PETROLEUM, INC.

By [Signature]

PLUGGING
 PREL SEC 6 T 21 R 13W
 ROCK PAGE 103 LINE 32

STATE OF KANSAS)
) SS:
 COUNTY OF SEDGWICK)

Subscribed to and sworn to before me, a Notary Public, in said County and State, this 16th day of March, 1953.

[Signature]
 Notary Public

My commission expires: October 13, 1954.