

STATE OF KANSAS  
STATE CORPORATION COMMISSION

Form CP-4

Give All Information Completely  
Make Required Affidavit  
Mail or Deliver Report to:  
Conservation Division  
State Corporation Commission  
212 No. Market  
Wichita, Kansas 67202

WELL PLUGGING RECORD

Finney County, Sec. 5 Twp. 21S Rge. (E) 33 (W)

Location as "NE/CNW/SW" or footage from lines 200' S of C SW SE

Lease Owner Thunderbird Drilling, Inc.

Lease Name Wampler Well No. 1

Office Address 4328 East Kellogg, Wichita, Kansas 67218

Character of Well (completed as Oil, Gas or Dry Hole) Dry Hole

Date well completed December 30, 1971

Application for plugging filed 19

Application for plugging approved 19


Plugging commenced December 30, 1971

Plugging completed December 30, 1971

Reason for abandonment of well or producing formation Dry Hole

If a producing well is abandoned, date of last production 19

Was permission obtained from the Conservation Division or its agents before plugging was commenced? Yes (Edgar Eyes of Sublette)

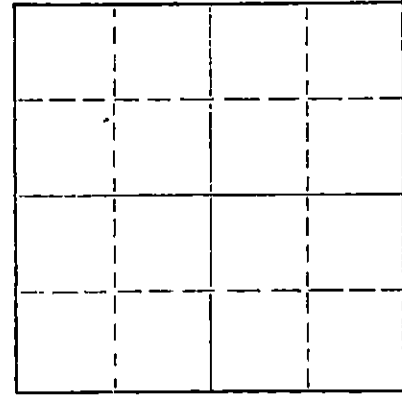

Locate well correctly on above Section Plat

Name of Conservation Agent who supervised plugging of this well

Producing formation Depth to top Bottom Total Depth of Well 4775 Feet

Show depth and thickness of all water, oil and gas formations.

OIL, GAS OR WATER RECORDS

CASING RECORD

FORMATION	CONTENT	FROM	TO	SIZE	PUT IN	PULLED OUT
	Surface	0	402'	8-5/8"	402'	----
	Casing					

Describe in detail the manner in which the well was plugged, indicating where the mud fluid was placed and the method or methods used in introducing it into the hole. If cement or other plugs were used, state the character of same and depth placed, from feet to feet for each plug set.

Mud from Total Depth to 400 Feet;  
Plug and 35 sax from 400 Feet to 300 Feet;  
Mud to 40 Feet, 1/2 sax Hulls, Plug and 15 sax to Base of Cellar; 2 sax in rat hole.  
Job completed @ 1:00 P.M.

RECEIVED  
STATE CORPORATION COMMISSION  
JAN 6 1972  
CONSERVATION DIVISION  
Wichita, Kansas

(If additional description is necessary, use BACK of this sheet)

Name of Plugging Contractor Globe Oilwell Cementing, Inc.

Address Box 628, Great Bend, Kansas 67530

STATE OF KANSAS COUNTY OF SEDGWICK ss.  
Clarence Michael of Sage Drilling Co. (employee, owner or operator) of the above described well

being first duly sworn on oath, says: That I have knowledge of the facts, statements, and matters herein contained and the log of the above-described well as filed and that the same are true and correct. So help me God.


(Signature) Clarence Michael

500 Bitting Building, Wichita, Kansas (Address)

SUBSCRIBED AND SWORN to before me this 31st day of December, 1971

Louise K. Whitted  
Louise K. Whitted - Notary Public.

My commission expires November 26, 1974

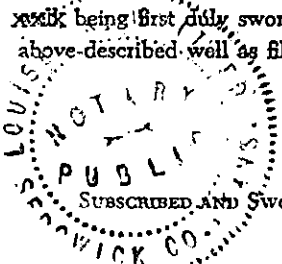

DRILLERS LOG

WAMPLER NO. 1

CASING RECORD:	OPERATOR:	Thunderbird Drlg., Inc.	DESCRIPTION:
8-5/8" @ 402' w/300 sax cement	CONTRACTOR:	Sage Drilling Co., Inc.	200' So. of C SW SE
TOTAL DEPTH:	COMMENCED:	December 16, 1971	Sec. 5-21S-33W
4775'	COMPLETED:	December 30, 1971	Finney County, Kansas

<u>FORMATION</u>	<u>FROM</u>	<u>TO</u>	<u>REMARKS</u>
Surface Sand & Clay	0	195	
Clay & Shale	195	403	
Clay, Shale & Sand	403	516	
Blue Shale & Red Bed	516	1510	
Shale	1510	1612	
Sand	1612	1750	
Shale & Gyp	1750	2045	
Shale	2045	2122	
Shale & Lime	2122	2845	
Shale	2845	2952	
Lime & Shale	2952	4564	
Lime	4564	4640	
Lime, Sand & Shale	4640	4665	
Lime	4665	4670	
Lime & Shale	4670	4720	
Lime	4720	4775	D&A

RECEIVED  
STATE CORPORATION COMMISSION  
JAN 6 1972  
CONSERVATION DIVISION  
Wichita, Kansas

I certify that this is a true and correct copy of the above log to the best of my knowledge.

SAGE DRILLING CO., INC.

By Clarence Michael  
Clarence Michael



Subscribed and sworn to before me this 31st day of December, 1971.

Louise K. Whitted  
Louise K. Whitted, Notary Public

My commission expires:  
November 26, 1974.