


WELL PLUGGING RECORD

Give All Information Completely
Make Required Affidavit
Mail or Deliver Report to:
Conservation Division
State Corporation Commission
212 No. Market
Wichita, Kansas

NORTH

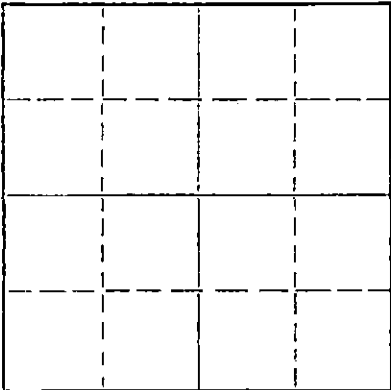

Locate well correctly on above
Section Plat

Barton County. Sec. 34 Twp. 16 Rge. 12 (E) W (W)
Location as "NE/CNW/SE/SW" or footage from lines. ~~000~~ ~~0000~~ SW NE NE
Lease Owner Shields Oil Producers Inc.
Lease Name Jenisch Well No. 1
Office Address Russell, Kansas
Character of Well (completed as Oil, Gas or Dry Hole) Oil well
Date well completed October 30 1954
Application for plugging filed March 13 1967
Application for plugging approved March 14 1967
Plugging commenced March 25 1967
Plugging completed March 31 1967
Reason for abandonment of well or producing formation Depleted oil well

If a producing well is abandoned, date of last production March 1967
Was permission obtained from the Conservation Division or its agents before plugging was commenced? Yes

Name of Conservation Agent who supervised plugging of this well Donald Dusen
Producing formation _____ Depth to top _____ Bottom _____ Total Depth of Well 3340 Feet
Show depth and thickness of all water, oil and gas formations.

OIL, GAS OR WATER RECORDS

CASING RECORD

FORMATION	CONTENT	SIZE	PUT IN	PULLED OUT
		8 5/8"	161'	Cont'd w/ 100 sacks
		5 1/2"	3,342'	2,747'

RECEIVED
STATE CORPORATION COMMISSION
MAY 31 1967
CONSERVATION DIVISION
Wichita, Kansas

Describe in detail the manner in which the well was plugged, indicating where the mud fluid was placed and the method or methods used in introducing it into the hole. If cement or other plugs were used, state the character of same and depth placed, from 3340 feet to SURFACE _____ feet for each plug set.

Sanded hole up 10' about perf. Dump 4 sacks of cement on bottom.
Pulled pipe from hole set rock bridge at 200' filled hole with ready-mix.
Well completed.

RECEIVED
STATE CORPORATION COMMISSION
MAY 31 1967
CONSERVATION DIVISION
Wichita, Kansas

(If additional description is necessary, use BACK of this sheet)

Name of Plugging Contractor Barnes & Sons Pipe Pulling Co.
Address P.O. Box 313 Russell, Kansas

STATE OF Kansas, COUNTY OF Russell, ss.
Jack P. Beerman (employee of owner) or (owner or operator) of the above-described well, being first duly sworn on oath, says: That I have knowledge of the facts, statements, and matters herein contained and the log of the above-described well as filed and that the same are true and correct. So help me God.

(Signature) Jack P. Beerman
Shields Bldg, Russell, Kansas (Address)

SUBSCRIBED AND SWORN TO before me this 29th day of May, 1967

My commission expires May 26, 1971

Notary Public.

WELL LOG

Shields Oil Producers
Jenisch #1

SW NE NE
Sec. 34, Twp. 16S, Rge. 12W
Barton County, Kansas

Total Depth: 3344'
Commenced: October 19, 1954
Completed: October 31, 1954
Drilled by Shields Drilling Co., Inc.

CASING RECORD

Size	Run	Cased
8 5/8	164'	cased w/100 sax
5 1/2	3342'	cased w/75 sax

Elevation: 1896' RB
Treatment:
Production

-----Figure: Indicate Bottom of Formation-----

Post Rock	45
Shale & Rock	161
Shale & Clay	250
Shale	520
Red Bed	770
Anhy. Lime	800
Shale & Red Bed	970
Shale & Shells	1225
Shale	1500
Lime & Shale	1645
Shale & Lime streaks	1805
Lime & Shale	1830
Lime	1915
Lime & Shale	2920
Lime	2982
Lime & Shale	3039
Lime	3105
Lime & Shale	3156
Lime	3160
Chalky Lime	3235
Lime	3331
Sandy Lime	3340
Arbuckle TD	3344
R. F. D.	3344

TOPS

Haebner	2961'	Lansing - KC	3069'
Toronto	2978'	Arbuckle	3340'
Brown Lime	3052'		

NOTES

DST #1 - 3072-3105 Gas to surface in 20 minutes. Received 60' oil and gas cut mud, 440' gasy oil. 150# FFP. 975# BHP. Tool open 1 hr., shut in 20 minutes.

DST #2 - 3144-3160 Gas to surface in 40 minutes. Received 850' oil cut water. 350# FFP. 950# BHP. Tool open 1 hr., shut in 20 minutes.

RECEIVED
STATE CORPORATION COMMISSION

MAR 14 1967

CONSERVATION DIVISION
Wichita, Kansas