

15-009-06303-00-00


STATE OF KANSAS  
STATE CORPORATION COMMISSION

WELL PLUGGING RECORD

Give All Information Completely  
Make Required Affidavit  
Mail or Deliver Report to:  
Conservation Division  
State Corporation Commission  
800 Bitting Building  
Wichita, Kansas

Barton County, Sec. 34 Twp. 16S Rge. 12W (E) (W)

Location as "NE/CNW%SW%" or footage from lines SW SW SW  
Lease Owner Mallard Drilling Company  
Lease Name Schneweis Well No. 1  
Office Address 1016 Union Nat'l. Bank - Wichita, Kansas  
Character of Well (completed as Oil, Gas or Dry Hole) Dry Hole  
Date well completed January 19 19 55  
Application for plugging filed \_\_\_\_\_ 19 \_\_\_\_\_  
Application for plugging approved \_\_\_\_\_ 19 \_\_\_\_\_  
Plugging commenced February 18 19 55  
Plugging completed February 22 19 55  
Reason for abandonment of well or producing formation \_\_\_\_\_

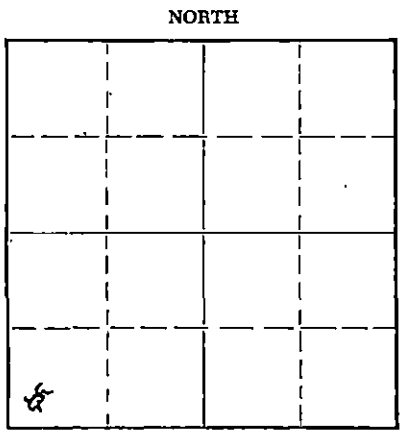

Locate well correctly on above Section Plat

If a producing well is abandoned, date of last production \_\_\_\_\_ 19 \_\_\_\_\_  
Was permission obtained from the Conservation Division or its agents before plugging was commenced? Yes

Name of Conservation Agent who supervised plugging of this well Warren H. Horner  
Producing formation \_\_\_\_\_ Depth to top \_\_\_\_\_ Bottom \_\_\_\_\_ Total Depth of Well 3351 Feet  
Show depth and thickness of all water, oil and gas formations.

OIL, GAS OR WATER RECORDS

CASING RECORD

| FORMATION | CONTENT | FROM | TO | SIZE   | PUT IN | PULLED OUT |
|-----------|---------|------|----|--------|--------|------------|
|           |         |      |    | 8-5/8" | 272'   | None       |
|           |         |      |    | 5-1/2" | 3228'  | 2923'      |
|           |         |      |    |        |        |            |
|           |         |      |    |        |        |            |
|           |         |      |    |        |        |            |
|           |         |      |    |        |        |            |

Describe in detail the manner in which the well was plugged, indicating where the mud fluid was placed and the method or methods used in introducing it into the hole. If cement or other plugs were used, state the character of same and depth placed, from \_\_\_\_\_ feet to \_\_\_\_\_ feet for each plug set.

Filled the hole with sand from 3351' to 3310' and ran 5 sacks of cement. Mudded and bailed the hole to 270', set a 10' rock bridge and ran 20 sacks of cement. Mudded the hole to the top and ran 10 sacks of cement. Plugging completed.

(If additional description is necessary, use BACK of this sheet)  
Name of Plugging Contractor West Supply Co., Inc.  
Address Chase, Kansas

STATE OF Kansas COUNTY OF Sedgwick, ss.  
C.C. Nelson (employee of owner) or (owner or operator) of the above-described well, being first duly sworn on oath, says: That I have knowledge of the facts, statements, and matters herein contained and the log of the above-described well as filed and that the same are true and correct. So help me God.  
(Signature) C.C. Nelson

SUBSCRIBED AND SWORN TO before me this 6th day of March (Address) 1955  
Lawell Wright Notary Public.  
My commission expires 12/4/56

**PLUGGING**  
FILE SEC 34 T 16 R 12W  
BOOK PAGE 25 LINE 6

RECEIVED  
STATE CORPORATION COMMISSION  
MAR 7 1955  
CONSERVATION DIVISION  
Wichita, Kansas  
3-7-1955

State

15-009-06303-00-00

COMPANY: C. C. Nelson  
 CONTRACTOR: Lewis Drilling Company  
 FARM: Schneweis #1  
 LOCATION: SW/4 SW/4 SW/4 Sec. 34-16-12W  
 Barton County, Kansas  
 COMMENCED: January 11, 1955  
 COMPLETED: January 19, 1955

|      |    |      |                                       |
|------|----|------|---------------------------------------|
| 0    | to | 65   | Surface sand                          |
| 65   | to | 265  | Sand and shale                        |
| 265  | to | 420  | Sand and shale streaks                |
| 420  | to | 940  | Red bed and shale                     |
| 940  | to | 960  | Anhydrite                             |
| 960  | to | 1350 | Shale                                 |
| 1350 | to | 1835 | Shale and shells                      |
| 1835 | to | 2715 | Shale and lime                        |
| 2715 | to | 2820 | Lime                                  |
| 2820 | to | 3310 | Shale and lime                        |
| 3310 | to | 3328 | Lime                                  |
| 3328 | to | 3331 | Arbuckle                              |
|      |    | 3331 | T.D. Rotary                           |
| 3331 | to | 3347 | Arbuckle-broken. No water or oil show |
| 3347 | to | 3351 | Water, show of oil.                   |
|      |    | 3351 | T.D. cardwell                         |

Set 272' of 8 5/8" surface pipe. Cemented with 175 sacks.  
 Set 5 1/2" at 3328. Cemented with 70 sacks cement.

Measurements taken from R.D.B. R.D.B. 4 feet from ground level.

Shot well from 3323 to 3328. No show oil or water.

DRY AND ABANDONED

C E R T I F I C A T E

I, C. C. NELSON, do hereby certify that the above and foregoing is a true and correct copy of log of the Schneweis #1, Barton County, Kansas, as reflected by files of the Mallard Drilling Company.

*C. C. Nelson*

Subscribed and sworn to before me a Notary Public, within and for Sedgwick County, Kansas, this 2nd day of February 1955.

*Harold Wright*

My commission expires 1/4/56

**PLUGGING**  
 FILE SEC. 34-16-12W  
 BOOK PAGE 95 LINE 6

RECEIVED  
 STATE CORPORATION COMMISSION  
 MAR 2 1955  
 CONSERVA. DIVISION  
