


WELL PLUGGING RECORD

Give All Information Completely
Make Required Affidavit
Mail or Deliver Report to:
Conservation Division
State Corporation Commission
800 Bitting Building
Wichita, Kansas

Stafford County. Sec. 3 Twp. 21 Rge. 13 ~~(S)~~ (W)
Location as "NE/CNW&SW" or footage from lines SW SW NW
Lease Owner Hilton Drilling Company, Inc.
Lease Name Jung Well No. 1
Office Address 2421 Tenth Street, Great Bend, Kansas
Character of Well: (completed as Oil, Gas or Dry Hole) Oil
Date well completed October 17, 19 54
Application for plugging filed September 12, 19 56
Application for plugging approved September 13, 19 56
Plugging commenced September 15, 19 56
Plugging completed September 18, 19 56
Reason for abandonment of well or producing formation _____

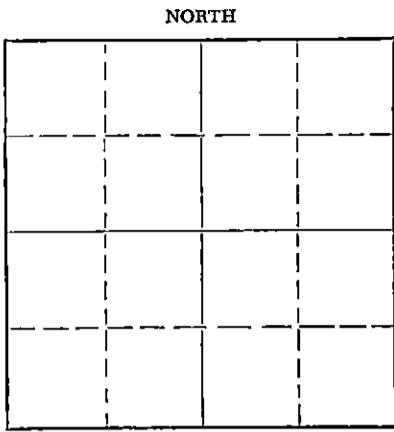

Locate well correctly on above
Section Plat

If a producing well is abandoned, date of last production September 13, 1956
Was permission obtained from the Conservation Division or its agents before plugging was commenced? Yes

Name of Conservation Agent who supervised plugging of this well R. M. Brundege
Producing formation _____ Depth to top _____ Bottom _____ Total Depth of Well 3390 Feet
Show depth and thickness of all water, oil and gas formations.

OIL, GAS OR WATER RECORDS

CASING RECORD

FORMATION	CONTENT	FROM	TO	SIZE	PUT IN	PULLED OUT
				6-1/2"	3393	2845
			213'	8-5/8"	213	None

Describe in detail the manner in which the well was plugged, indicating where the mud fluid was placed and the method or methods used in introducing it into the hole. If cement or other plugs were used, state the character of same and depth placed, from _____ feet to _____ feet for each plug set.

Plugged back with sand from 3460' to 3420' and dumped 5 sacks cement with dump bailer.
Pulled casing, mudded hole with chunk mud to 210', set rock bridge from 210' to 205' and dumped 20 sacks cement.
Mudded surface to 35', set rock bridge from 35' to 30', mixed and poured 10 sacks cement from 30' to top of surface casing.

(If additional description is necessary, use BACK of this sheet)

Name of Plugging Contractor Ace Pipe Pulling Company
Address Great Bend, Kansas

STATE OF KANSAS, COUNTY OF BARTON, ss.
Henry Peacock, Secretary (employee of owner) or (owner or operator) of the above-described well, being first duly sworn on oath, says: That I have knowledge of the facts, statements, and matters herein contained and the log of the above-described well as filed and that the same are true and correct. So help me God.

(Signature) Henry Peacock
Great Bend, Kansas
(Address)

SUBSCRIBED AND SWORN TO before me this 19th day of September, 19 56

My commission expires Jan. 24, 1959

Carmen [Signature]
STATE CORPORATION COMMISSION Notary Public.

24-7388-5 3-53-20M

CONSERVATION DIVISION
Wichita, Kansas
9-20-1956

PLUGGING
FILE SEC 3 T. 21 R. 13W
BOOK PAGE 98 LINE 25

WELL LOG BUREAU--KANSAS GEOLOGICAL SOCIETY
508 East Murdock, Wichita, Kansas


15.185.01669.0000

Company- PETROLEUM, INC.
Farm- Jung No. 1

SEC. 3 T. 21 R. 13W
SW SW NW

Total Depth. 3557
Comm. 7-21-54 Comp. 7-31-54
Shot or Treated.
Contractor. Garvey Drilling Co.
Issued. 11-13-54

County Stafford
KANSAS

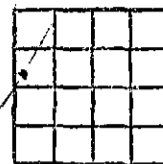

Elevation. 1886 RB

Production. Dry

CASING:

8 5/8 @ 213' w/ 175 sx cmt.
5 1/2 @ 3534' w/ 100 sx cmt.

Figures Indicate Bottom of Formations.

shale & sand	126
sand	143
shale	155
shale & shells	213
shale	280
red bed & sand	741
anhydrite	775
shale & shells	830
shale, shells & red bed	1470
shale & shells	1555
lime & shale	3016
lime	3131
shale	3260
lime & shale	3322
lime	3495
lime & shale	3537
lime	3557
Total Depth	

TOPS:

Heebner	3137
Brown lime	3261
Lansing	3276
Simpson	3500
Arbuckle	3531

RECEIVED
STATE CORPORATION COMMISSION
SEP 26 1956
CONSERVATION DIVISION
Wichita, Kansas

PLUGGING
FILE SEC. 3 T. 21 R. 13W
BOOK PAGE 98 LINE 25