

STATE OF KANSAS
STATE CORPORATION COMMISSION

WELL PLUGGING RECORD

FORMATION PLUGGING RECORD

Give All Information Completely
Make Required Affidavit
Mail or Deliver Report to:
Conservation Division
State Corporation Commission
800 Biting Building
Wichita, Kansas

Strike out upper line
when reporting plug-
ging off formations.

Stafford County. Sec. 3 Twp. 21 Rge. (E) 13 (W)

Location as "NE 1/4 NW 1/4 SW 1/4" or footage from lines NW NW SE 1/4

Lease Owner Armer Drilling Company, Inc.

Lease Name McDonald Well No. 1

Office Address 306 Insurance Bldg., Wichita 2, Kansas

Character of Well (completed as Oil, Gas or Dry Hole) Dry

Date well completed April 25 19 49

Application for plugging filed April 25 19 49

Application for plugging approved April 26 19 49


Plugging commenced April 26 19 49

Plugging completed April 26 19 49

Reason for abandonment of well or producing formation Dry

If a producing well is abandoned, date of last production 19

Was permission obtained from the Conservation Division or its agents before plugging was com-
menced? Yes

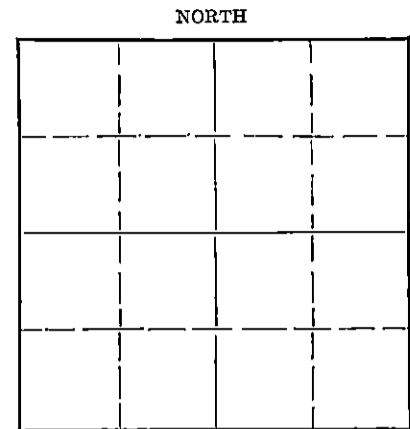

Locate well correctly on above
Section Plat

Name of Conservation Agent who supervised plugging of this well C. D. Stough

Producing formation Simpson Depth to top 3544 Bottom Total Depth of Well Feet

Show depth and thickness of all water, oil and gas formations.

OIL, GAS OR WATER RECORDS

CASING RECORD

Formation	Content	From	To	Size	Put In	Pulled Out
				8-5/8"	205	none

Describe in detail the manner in which the well was plugged, indicating where the mud fluid was placed and the method or methods used in introducing it into the hole. If cement or other plugs were used, state the character of same and depth placed, from feet to feet for each plug set.

Hole full of heavy mud from bottom up to 200 ft.
Set plug and 15 sacks cement at 200 ft. Filled with
heavy mud from 200 ft. to 30 ft. Set plug and
10 sacks cement at surface.

RECEIVED
Conservation Div.
MAY 10 1949
5-10-1949
STATE CORPORATION
COMMISSION
KANSAS

(If additional description is necessary, use BACK of this sheet)

Correspondence regarding this well should be addressed to Armer Drilling Company, Inc.
Address 306 Insurance Bldg., Wichita, Kansas

STATE OF Kansas, COUNTY OF Sedgwick, ss.

M. B. Armer, President of (Employee or owner) of the above-described well,
being first duly sworn on oath, says: That I have knowledge of the facts, statements, and matters herein contained and the log of the above-
described well as filed and that the same are true and correct. So help me God.

(Signature) M. B. Armer

306 Insurance Bldg., Wichita, Kansas
(Address)

SUBSCRIBED AND SWORN to before me this 9th day of May, 19 49.

Notary Public

My commission expires Sept. 17, 1951

PLUGGING
FILE SEC 3 T 21 R 130
BOOK PAGE 93 LINE 30

Owner: Armer Drilling Company, Inc.
 Contractor: Armer Drilling Company, Inc.
 Drilling commenced: 4/9/49
 Drilling completed: 4/26/49
 Elevation: 1884'
 Rotary Rig #2

Farm: McDonald #1
 Location: NW NW SE 1/4
 3-21S-13W
 Stafford Co., Kansas
 Casing Record: 8-5/8" set @ 205' R.B.
 cemented w/250 sacks cement

(figures below indicate bottom)

Sand	195
Shale	210
Red bed & shale	720
Anhydrite	745
Shale	1105
Shale & shells	1280
Shale	1585
Shale & lime	1600
Lime	1845
Shale	1865
Lime	1965
Lime & shale	2160
Shale, shells	2240
Shale & lime	2340
Shale & shells	2470
Shale	2705
Shale & shells	2780
Lime & shale	3010
Lime	3160
Lime & shale	3302
Lime	3520
Lime, shale & shells	3543
Shale	3626
Conglomerate & shale	3628
Total Depth	3628 - D & A
TOPS:	
Brown Lime	3278
Kansas City	3289
Base of Kansas City	3527
Cherty Conglomerate	3540
Simpson Shale	3545

I heroby certify that this is a true and correct log of the above described well as shown by the drilling reports.

Armer Drilling Company, Inc.

By

M.B. Smith
 STATE CORPORATION

RECEIVED
 Conservation Div.
 MAY 10 1949
 COMMISSION
 KANSAS

State of Kansas }
 County of Sedgwick } SS

Subscribed and sworn to before me, a notary public, in and for said County and State this 29th day of April, 1949.

Hazel Walton
 Notary Public

My commission expires
 Sept. 17, 1951.

PLUGGING
 NW SEC 3 T 21 R 13 W
 BOOK PAGE 93 LINE 30