

STATE OF KANSAS
STATE CORPORATION COMMISSION

Form CP-4

WELL PLUGGING RECORD

Stafford County, Sec. 3 Twp. 21S Rge. 13W (E) (W)

Location as "NE/CNW/SE/SW" or footage from lines SE NW NE

Lease Owner Kewanee Oil Company

Lease Name Sharp B Well No. 2

Office Address Box 2093, Wichita, Kansas 67201

Character of Well (completed as Oil, Gas or Dry Hole) Oil

Date well completed 3-23 19 61

Application for plugging filed 1-10 19 72

Application for plugging approved 1-11 19 72


Plugging commenced 1-24-19 72

Plugging completed 1-29-19 72

Reason for abandonment of well or producing formation Dry

If a producing well is abandoned, date of last production 4-23 19 65

Was permission obtained from the Conservation Division or its agents before plugging was commenced? Yes

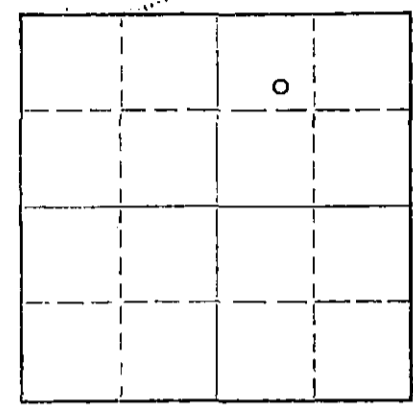

Locate well correctly on above Section Flat

Name of Conservation Agent who supervised plugging of this well Herman Justice

Producing formation Arbuckle Depth to top 3553 Bottom 2628 Total Depth of Well 3628 Feet

Show depth and thickness of all water, oil and gas formations.

OIL, GAS OR WATER RECORDS

CASING RECORD

FORMATION	CONTENT	FROM	TO	SIZE	PUT IN	PULLED OUT
Kansas City	Dry	3269'		5-1/2"	3627'	2424.57'
Arbuckle	Dry	3553'		8-5/8"	212'	None

Describe in detail the manner in which the well was plugged, indicating where the mud fluid was placed and the method or methods used in introducing it into the hole. If cement or other plugs were used, state the character of same and depth placed, from _____ feet to _____ feet for each plug set.

Made bottom hole plug back with sand to 3540'. Mixed and ran 5 sacks cement through dump bailer. Squeezed hole with 2 sacks hulls, 15 sacks gel and 100 sacks cement to base of cellar.

RECEIVED
STATE CORPORATION COMMISSION
FEB 14 1972
CONSERVATION DIVISION
Wichita, Kansas

Name of Plugging Contractor Southwest Casing Pulling Company


Address Box 364, Great Bend, Kansas

STATE OF Kansas COUNTY OF Sedgwick, ss. (Kewanee) C. W. Mosier (employee of owner) or (owner) of the above-described well, being first duly sworn on oath, says: That I have knowledge of the facts, statements, and matters herein contained and the log of the above-described well as filed and that the same are true and correct. So help me God. C. W. Mosier

(Signature) [Signature]

Box 2093, Wichita, Kansas 67201 (Address)

SUBSCRIBED AND SWORN TO before me this 11th day of February, 19 72

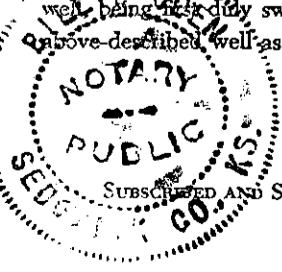

[Signature] Billie Oden Notary Public.

My commission expires 8-10-75

ALPINE'S FANNIE SHARP NO. 2-B
 SE SE NW NE Sec. 3-21S-13W
 Stafford County, Kansas

Elevation 1884 KB

1-20-61 Moved in - set 8 5/8 at 212 ft. with
 250 sacks - completed 6:30 P.M.
 1-21-61 430
 1-22-61 1710
 1-23-61 2060
 1-24-61 2490
 1-25-61 2900
 1-26-61 3185
 1-27-61 3347

Anhydrite 723 +1161
 Heebner 3132-1248
 Brown Lime 3254-1370
 Lansing 3269-1385
 Base/ K.C. 3506-1622
 Conglomerate 3545-1661
 Arbuckle 3553-1669
 5 1/2" Casing 3627 with 125 sacks
 Rotary Total Depth 3628-1744

DST #1 3280 to 3330
 Open 1 hr., rec. 6 ft. mud - 710# BHP

DST #2 3332 to 3347
 Open 1 hr., weak blow, rec. 165 ft. gas,
 55 ft. S.O.C.M., 10 ft. watery mud -
 BHP 475#

DST #3 3347 to 70
 Open 1 hr., rec. 50 ft. water - IBHP
 875#; FBHP 835#

DST #4 3388 to 3445
 Open 1 hr., weak blow, rec. 95 ft. of
 very slightly gas cut & oil specked
 mud - IBHP 1070# - FBHP 150#

Note: Well purchased from Alpine, do not have
 driller's log in file.

RECEIVED
 STATE CORPORATION COMMISSION
 JAN 11 1972
 CONSERVATION DIVISION
 Wichita, Kansas