


STATE OF KANSAS
STATE CORPORATION COMMISSION

WELL PLUGGING RECORD

Give All Information Completely
Make Required Affidavit
Mail or Deliver Report to:
Conservation Division
State Corporation Commission
211 No. Broadway
Wichita, Kansas

Stafford County. Sec. 5 Twp. 21 Rge. (E) 13 (W)
Location as "NE/CNW%SW%" or footage from lines SW SE SE
Lease Owner Petroleum, Inc.
Lease Name NEWCOMBE 'E' Well No. 1
Office Address 311 East Third, Wichita, Kansas
Character of Well (completed as Oil, Gas or Dry Hole) Dry Hole
Date well completed March 31 19 56
Application for plugging filed March 31 19 56
Application for plugging approved March 31 19 56
Plugging commenced March 31 19 56
Plugging completed March 31 19 56
Reason for abandonment of well or producing formation Dry Hole

NORTH

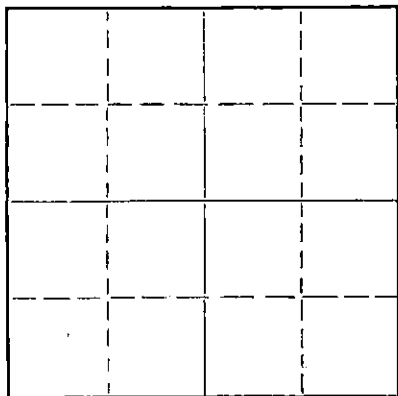

Locate well correctly on above
Section Plat

If a producing well is abandoned, date of last production _____ 19____
Was permission obtained from the Conservation Division or its agents before plugging was commenced? yes

Name of Conservation Agent who supervised plugging of this well Mr. R. M. Brundege, Hoisington, Kansas
Producing formation _____ Depth to top _____ Bottom _____ Total Depth of Well 3647 Feet
Show depth and thickness of all water, oil and gas formations.

OIL, GAS OR WATER RECORDS

CASING RECORD

FORMATION	CONTENT	FROM	TO	SIZE	PUT IN	PULLED OUT
				8-5/8"	197'	None

Describe in detail the manner in which the well was plugged, indicating where the mud fluid was placed and the method or methods used in introducing it into the hole. If cement or other plugs were used, state the character of same and depth placed, from _____ feet to _____ feet for each plug set.

Mud up with heavy mud to 210', pushed down
1/3 sack hulls to 210' followed by wooden plug.
Placed 20 sacks cement through drill pipe on
top of plug. Mud up to 35' and placed 1/3 sack
hulls at 35' followed by wooden plug and 10
sacks cement to base of well cellar.

(If additional description is necessary, use BACK of this sheet)

Name of Plugging Contractor Garvey Drilling Company
Address R. R. #2 - Great Bend, Kansas

STATE OF KANSAS, COUNTY OF SEDGWICK, ss.
Cullen Thomas (employee of owner) or (~~owner or operator~~) of the above-described well, being first duly sworn on oath, says: That I have knowledge of the facts, statements, and matters herein contained and the log of the above-described well as filed and that the same are true and correct. So help me God.

(Signature) Cullen Thomas
311 East Third, Wichita, Kansas
(Address)

SUBSCRIBED AND SWORN TO before me this 31st day of March, 19 56

My commission expires September 2, 1959
Frances Sloan
Notary Public.

FRANCES SLOAN, Notary Public
My Commission expires Sept. 2, 1959

PLUGGING
FILE SEC 5 T 21 R 3W
BOOK PAGE 50 LINE 35

4-11-1956

WELL LOG

15.185.11708.0000

COMPANY **Petroleum, Inc.**

SEC. **5** T. **21S** R. **13W**

FARM **NEWCOMBE 'E'** NO. **1**

LOC. **SW SE SE**
330' FSL
990' FEL


TOTAL DEPTH **3647'**

COUNTY **Stafford**

COMM. **March 21, 1956**

COMP. **March 31, 1956**

CONTRACTOR **Garvey Drilling Company**

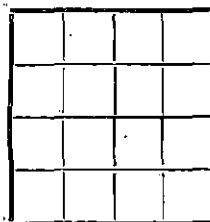

CASING **8-5/8" @ 197' w/200 saz**

ELEVATION **1901' DF**
1903' RB

PRODUCTION **D & A**

FIGURES INDICATE BOTTOM OF FORMATIONS

190	Sand & Shale
197	Shale
240	Shale & Shells
300	Sand
600	Red Bed
760	Sand & Shells
805	Anhydrite
1225	Sand & Shale
1615	Shale & Shells
3113	Lime & Shale
3116	Lime & Chert
3647	Lime & Shale

Sample Tops

Hoebner	3194	(-1291)
Toronto	3214	(-1311)
Douglas	3234	(-1331)
Brn Lime	3313	(-1410)
Lansing	3326	(-1423)
BKC	3511	(-1611)
Conglomerate	3562	(-1659)
Simpson	3593	(-1690)
Arbuckle	3610	(-1707)

RTD 3647'

State of KANSAS }
 County of SEDGWICK } ss:
 I, Cullen Thomas

APR 11 1956
 CONSERVATION DIVISION
 Wichita, Kansas
Petroleum, Inc.

upon oath state that the above and foregoing is a true and correct copy of the log of the NEWCOMBE 'E' #1 well

Cullen Thomas

Subscribed and sworn to before me this 6th day of April 1956

My Commission Expires: September 2, 1959

Frances Sloan
NOTARY PUBLIC

PLUGGING
 FEL SEC 5 T 21 R 13W
 BOOK PAGE 50 LINE 35

FRANCES SLOAN, Notary Public
My Commission expires Sept. 2, 1959