


WELL PLUGGING RECORD

Give All Information Completely
Make Required Report
Mail or Deliver Report to:
Conservation Division
State Corporation Commission
211 No. Broadway
Wichita, Kansas

Stafford County. Sec. 5 Twp. 21 Rge. (E) 13 (W)

Location as "NE/CNW/SW" or footage from lines N/2 NW NE
Lease Owner Chief Drilling Company
Lease Name Newcomb Well No. 1
Office Address Box 787, Great Bend, Kansas
Character of Well (completed as Oil, Gas or Dry Hole) oil
Date well completed 19
Application for plugging filed May 9 19 63
Application for plugging approved 19
Plugging commenced May 10 19 63
Plugging completed May 16 19 63
Reason for abandonment of well or producing formation depleted

NORTH

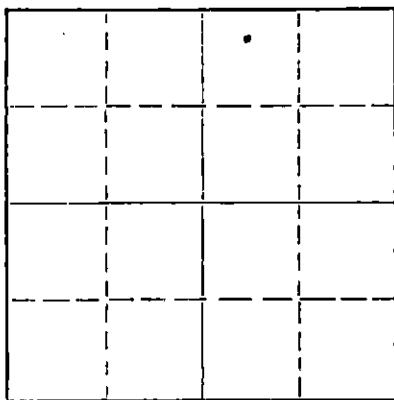

Locate well correctly on above
Section Plat

If a producing well is abandoned, date of last production 19
Was permission obtained from the Conservation Division or its agents before plugging was commenced? yes

Name of Conservation Agent who supervised plugging of this well W. L. Lackamp
Producing formation Depth to top Bottom Total Depth of Well 3592 Feet
Show depth and thickness of all water, oil and gas formations.

OIL, GAS OR WATER RECORDS

CASING RECORD

FORMATION	CONTENT	FROM	TO	SIZE	PUT IN	PULLED OUT
		0	210	8 5/8	210	none
		0	3591	4 1/2	3591	2818.61

Describe in detail the manner in which the well was plugged, indicating where the mud fluid was placed and the method or methods used in introducing it into the hole. If cement or other plugs were used, state the character of same and depth placed, from feet to feet for each plug set.

Pushed plug with bailer to 3400', set 10' rock bridge.

Mixed 3 sacks of cement and dumped at 3390'.

Fill hole with mud. Set plug at 195', plug did not hold.

Pump in through casing 10 sacks gel and 60 sacks cement.

Capped hole with 10 sacks cement.

RECEIVED
STATE CORPORATION COMMISSION

MAY 27 1963

CONSERVATION DIVISION
Wichita, Kansas

(If additional description is necessary, use BACK of this sheet)
Name of Plugging Contractor Pipe Pullers, Inc.
Address Box 486, Ellinwood, Kansas

STATE OF Kansas COUNTY OF Barton, ss.
Dean Wells (employee of owner) or (owner or operator) of the above-described

well, being first duly sworn on oath, says: That I have knowledge of the facts, statements, and matters herein contained and the log of the above-described well as filed and that the same are true and correct. So help me God.

(Signature) Sean Steer

Ellinwood, Kansas

(Address)

SUBSCRIBED AND SWORN to before me this 22 day of May, 19 63

[Signature]

My commission expires July 7, 1964

Notary Public.

MAY 27 1963

WELL LOG

Chief Drilling Co., Inc.
Box 797
Great Bend, Kansas

NEWCOMBE #1
C N/2 NW NE Sec. 5-21S-13W
Stafford County, Kansas

CONSERVATION Laws
Wichita, Kansas

Commenced: 3-12-63
Completed: 3-20-63

Casing Record 8-5/8" @ 210' w/225 sacks Sunset Cement.
4-1/2" @ 3591' w/150 sacks Salt Saturated Cement.

FORMATION	FROM	TO
Sand & Shale	0	135
Tyrilite, Sand & Shale	135	150
Shale	150	210
Shale & Red Bed	210	560
Shale & Shells	560	1625
Shale & Lime Streaks	1625	1660
Lime & Shale	1660	2804
Lime	2804	3165
Shale & Lime	3165	3294
Lime	3294	3513
Conglomerate	3513	3593
Solonchite	3593	3593
Total Depth	3593	

ELEVATION

1892 Cr.
1894 O.F.
1897 K.B.

FORMATION TOPS

Anhydrite (drillers)	768	-1129
Topeka	2804	-907
Heebner	3165	-1265
Toronto	3184	-1287
Douglas	3202	-1305
Brown Lime	3282	-1385
Lansing	3294	-1397
Base Kansas City	3513	-1616
Shaley Conglomerate	3520	-1629
Cherty Conglomerate	3550	-1653
Arbuckle	3563	-1666
Total Depth	3592	-1695

STATE OF KANSAS, COUNTY OF BARTON) SS

I hereby certify that the above is a true and correct copy of the Driller's Log of the well drilled in the C N/2 NW NE Sec. 5-21S-13W, Stafford County, Kansas, to the best of my knowledge and belief.

CHIEF DRILLING CO., INC.

V. Richard Hoover
V. Richard Hoover, President

Subscribed and sworn to before me this 25th day of March, 1963.

Carmen R. Cook
Carmen R. Cook, Notary Public

My commission expires: Jan. 26, 1967.