


WELL PLUGGING RECORD

Give All Information Completely
Make Required Affidavit
Mail or Deliver Report to:
Conservation Division
State Corporation Commission
800 Bittling Building
Wichita, Kansas

Stafford County, Sec. 5 Twp. 21 Rge. 13 (NE) (W)

Location as "NE/CNW $\frac{1}{4}$ /SW $\frac{1}{4}$ " or footage from lines SW SW SE
Lease Owner Petroleum, Inc.
Lease Name Newcombe 'C' Well No. 1
Office Address 100 Derby Bldg., Wichita, Kansas
Character of Well (completed as Oil, Gas or Dry Hole) Dry Hole
Date well completed May 16, 19 52
Application for plugging filed May 16, 19 52
Application for plugging approved May 16, 19 52
Plugging commenced May 16, 19 52
Plugging completed May 16, 19 52
Reason for abandonment of well or producing formation Dry Hole

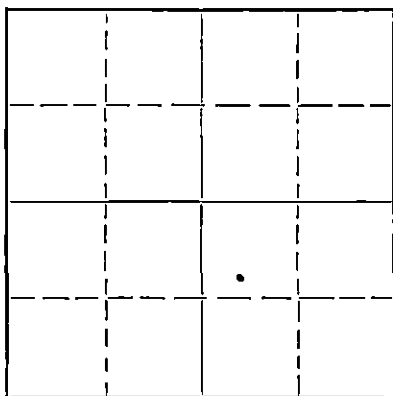

Locate well correctly on above Section Plat

If a producing well is abandoned, date of last production 19...
Was permission obtained from the Conservation Division or its agents before plugging was commenced? Yes

Name of Conservation Agent who supervised plugging of this well Mr. C. D. Stough
Producing formation... Depth to top... Bottom... Total Depth of Well 3635 Feet
Show depth and thickness of all water, oil and gas formations.

OIL, GAS OR WATER RECORDS

CASING RECORD

Formation	Content	From	To	Size	Put In	Pulled Out
				8 5/8"	232'	None

Describe in detail the manner in which the well was plugged, indicating where the mud fluid was placed and the method or methods used in introducing it into the hole. If cement or other plugs were used, state the character of same and depth placed, from... feet to... feet for each plug set.

Mudded up to 210' and placed wooden plug at 210'. Cemented and displaced 20 sacks cement through drill pipe on top of plug at 210'. Mudded up to 35' and placed second wooden plug at 35', and filled hole to base of cellar with 10 sacks cement on top of plug at 35'.

RECEIVED
STATE CORPORATION COMMISSION
MAY 23 1952
CONSERVATION DIVISION
Wichita, Kansas

Name of Plugging Contractor Garvey Drilling Company
Address R. R. #2, Great Bend, Kansas

STATE OF KANSAS, COUNTY OF SEDGWICK, ss.
W. W. Fisher (employee of owner) of the above-described well, being first duly sworn on oath, says: That I have knowledge of the facts, statements, and matters herein contained and the log of the above-described well as filed and that the same are true and correct. So help me God.

(Signature) *W. W. Fisher*
100 Derby Building, Wichita, Kansas (Address)

SUBSCRIBED AND SWORN to before me this 20th day of May, 19 52
Charlotte Menden
Notary Public.

My commission expires October 13, 1954.

PLUGGING
FILE SEC 5 T 21 R 13
BOOK PAGE 16 LINE 31

15.195.11727.0000

DRILLER'S LOG NEWCOMBE 'C' #1

Petroleum, Inc., Lease Owner
Garvey Drilling Company, Contractor
Drilling Commenced: May 7, 1952
Drilling Completed: May 16, 1952
Casing Record: 8 5/8" @ 232' w/175 sax

Section 5, Twp. 21S, Rge. 13W
Location: SW SW SE
County: Stafford
R.T.D.: 3635'
Production: D & A

Figures below indicate bottom of formation

98 Surface Clay and Sand
150 Hard Sandstone
232 Shale & Shells
335 Grey Sand & Shale
600 Red Bed
780 Red Bed & Shale
805 Anhydrite
1410 Shale & Shells
2110 Lime & Shale
2235 Shale & Shells
3410 Lime & Shale
3472 Lime
3583 Lime & Shale
3635 Conglomerate

3635' R.T.D.

Tops:

Heebner: 3201 (-1292)
Brown Lime: 3322 (-1413)
Lansing: 3333 (-1424)
Conglomerate: 3583 (-1674)

DST #1, 3364-3432, open 1 hour,
rec. 90' mud, 900# BHP.

I hereby certify that this is a true and correct log of the above mentioned well.

PETROLEUM, INC.

By W.W. Fisher
W. W. Fisher

STATE OF KANSAS :
 : SS:
COUNTY OF SEDGWICK:

Subscribed to and sworn to before me, a Notary Public in said County and State, this 20th day of May, 1952.

PLUGGING
FILE SEC 5 T 21 R (3)
BOOK PAGE 16 LINE 31

My commission expires: October 13, 1954.

Charlotte Therman
Notary Public
RECEIVED
STATE CORPORATION COMMISSION
MAY 23 1952
CONSERVATION DIVISION
Wichita, Kansas