

STATE OF KANSAS
STATE CORPORATION COMMISSION

WELL PLUGGING RECORD

Give All Information Completely
Make Required Affidavit
Mail or Deliver Report to:
Conservation Division
State Corporation Commission
800 Biting Building
Wichita, Kansas

Stafford County, Sec. 5 Twp. 21 Rge. 13 (W)

Location as "NE/CNW/SW" or footage from lines. SW SE SW

Lease Owner Petroleum, Inc.

Lease Name Newcombe 'A' Well No. 3

Office Address 305 East Third, Wichita, Kansas

Character of Well (completed as Oil, Gas or Dry Hole) Dry Hole

Date well completed January 12, 1953 19

Application for plugging filed January 12, 1953

Application for plugging approved January 12, 1953

Plugging commenced January 12, 1953


Plugging completed January 12, 1953

Reason for abandonment of well or producing formation

Dry Hole

If a producing well is abandoned, date of last production 19

Was permission obtained from the Conservation Division or its agents before plugging was commenced? Yes

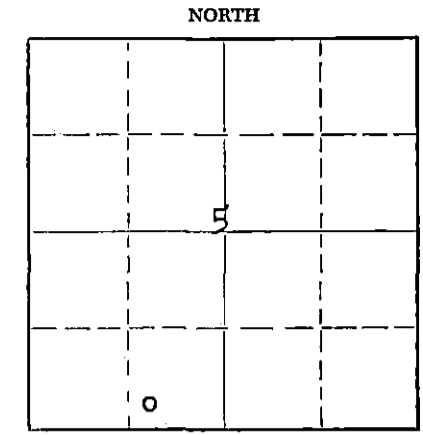

Locate well correctly on above Section Plat

Name of Conservation Agent who supervised plugging of this well Mr. M. A. Rives

Producing formation Depth to top Bottom Total Depth of Well 3650 Feet

Show depth and thickness of all water, oil and gas formations.

OIL, GAS OR WATER RECORDS

CASING RECORD

FORMATION	CONTENT	FROM	TO	SIZE	PUT IN	PULLED OUT
				8 5/8"	218'	None

Describe in detail the manner in which the well was plugged, indicating where the mud fluid was placed and the method or methods used in introducing it into the hole. If cement or other plugs were used, state the character of same and depth placed, from feet to feet for each plug set.

Mudded up to 210' and set wooden plug at 210'. Cemented and displaced 20 sacks cement through drill pipe onto plug at 210'. Mudded up to 35' and set second wooden plug. Filled hole to bottom of well cellar with 10 sacks cement.

RECEIVED
STATE CORPORATION COMMISSION
JAN 17 1953
CONSERVATION DIVISION
Wichita, Kansas

Name of Plugging Contractor Garvey Drilling Company
Address R. R. #2, Great Bend, Kansas

1-17-1953

STATE OF KANSAS, COUNTY OF SEDGWICK, ss. W. W. Fisher (employee of owner)

well, being first duly sworn on oath, says: That I have knowledge of the facts, statements, and matters herein contained and the log of the above-described well as filed and that the same are true and correct. So help me God.

(Signature) W. W. Fisher

305 East Third, Wichita, Kansas (Address)

SUBSCRIBED AND SWORN TO before me this 16th day of January, 1953

Charlotte Heisman Notary Public.

My commission expires October 13, 1954

PLUGGING
FILE SEC 5-7-21-132
BOOK PAGE 72 LINE 38

DRILLER'S LOG NEWCOMBE 'A' #3

Petroleum, Inc., Operator

Section 5, Twp. 21S, Rge. 13W

Garvey Drilling Company, Contractor

Location: SW SE SW

Drilling Commenced: December 31, 1952

County: Stafford County, Kansas

Drilling Completed: January 12, 1953

R.T.D.: 3650'

Casing Record: 8 5/8" C 218' w/175 sax

Production: D & A

Figures below indicate bottom of formation:

106	Gravel
135	White Sand
145	Hard Sand
1765	Shale & Shells
2100	Lime
2325	Lime & Shale
2710	Shale & Shells
3060	Lime & Shale
3650	Lime
3650'	R.T.D.

Tops:

Heebner:	3195 (-1284)
Brown Lime:	3315 (-1402)
Lansing:	3327 (-1416)
Arbuckle:	3548 (-1687)

DST #1, 3442-3463, open 30 mins., rec. 15' mud, 0% BHP.

DST #2, 3485-3500, open 1 hr., rec. 15' mud, 0% BHP.

DST #3, 3549-3602, open 1 hr., rec. 5' mud 0% BHP.

DST #4, 3598-3630, open 30 mins., rec. 25' mud, 5' slightly oil cut mud, 50% BHP.

DST #5, 3630-40, open 1 hr., rec. 58' mud, 1190% BHP.

I hereby certify that this is a true and correct log of the above mentioned well.

PETROLEUM, INC.

By W. W. Fisher

STATE OF KANSAS)
) ss:
 COUNTY OF SEDGWICK)

Sworn to and subscribed to before me, a Notary Public, in said County and State, this 14th day of January, 1953.

Charlotte Friedman

Notary Public
 RECEIVED
 STATE COMMISSION

My commission expires: October 13, 1954.

JAN 17 1953

CONSERVATION DIVISION
 Wichita, Kansas

PLUGGING
 FILE SEC 5 T 21 R 132
 BOOK PAGE 72 JMW 38