


STATE OF KANSAS
STATE CORPORATION COMMISSION

WELL PLUGGING RECORD

Give All Information Completely
Make Required Affidavit
Mail or Deliver Report to
Conservation Division
State Corporation Comm.
245 North Water
Wichita, KS 67202

Stafford County. Sec. 5 Twp. 21 Rge. 13 E/W
Location as "NE/CNW $\frac{1}{4}$ SW $\frac{1}{4}$ " or footage from lines
NW NW SW

Lease Owner Mohawk Drilling, Inc.
Lease Name Newcombe Well No. 1
Office Address P. O. Box 1362, Great Bend, Ks. 67530
Character of Well (Completed as Oil, Gas or Dry Hole)

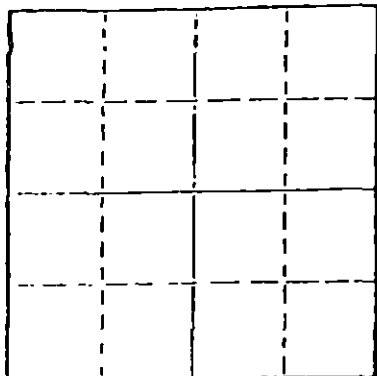

Locate well correctly on above
Section Plot

Dry Hole
Date Well completed August 20 1976
Application for plugging filed August 20 1976
Application for plugging approved August 20 1976
Plugging commenced August 20 1976
Plugging completed August 20 1976

Reason for abandonment of well or producing formation
Dry Hole
If a producing well is abandoned, date of last production 19

Was permission obtained from the Conservation Division or
its agents before plugging was commenced? yes

Name of Conservation Agent who supervised plugging of this well G. R. Biberstein
Producing formation Depth to top Bottom Total Depth of Well 3632
Show depth and thickness of all water, oil and gas formations.

OIL, GAS OR WATER RECORDS

CASING RECORD

FORMATION	CONTENT	FROM	TO	SIZE	PUT IN	PULLED OUT

Describe in detail the manner in which the well was plugged, indicating where the mud fluid was placed and the method or methods used in introducing it into the hold. If cement or other plugs were used, state the character of same and depth placed, from _____ feet to _____ feet for each plug set.

Bottom plug @ 300' w/35 sacks cement thru drill pipe.
Top plug @ 40' w/15 sacks cement.
5 sacks cement in rat hole.

RECEIVED
STATE CORPORATION COMMISSION

AUG 25 1976

CONSERVATION DIVISION
Wichita, Kansas

(If additional description is necessary, use BACK of this sheet)

Name of Plugging Contractor Duke Drilling Co.

STATE OF KANSAS COUNTY OF BARTON, ss.
Larry Curtis (employee of owner) or (owner/owner operator)
of the above-described well, being first duly sworn on oath, says: That I have knowledge of the facts, statements, and matters herein contained and the log of the above-described well as filed and that the same are true and correct. So help me God.

(Signature) Larry Curtis
Box 823, Great Bend, Kansas
(Address)

SUBSCRIBED AND SWORN TO before me this 20th day of August, 19 76

Donald M. Hague
Notary Public.

My commission expires April 11, 1978

DRILLERS' WELL LOG

DATE COMMENCED: August 14, 1976
DATE COMPLETED: August 20, 1976

Mohawk Drilling, Inc.
NEWCOMBE # 1
NW NW SW
Sec 5-P21-R13W
Stafford County, Kansas

ELEVATION: 1905 K.B.

0 - 175'	Sand, Clay, Hard Sand
175 - 433'	Shale
433 - 787'	Shale, Red Bed
787 - 808'	Anhydrite
808 - 1593'	Shale
1593 - 3202'	Shale and Lime
3202 - 3206'	Shale
3206 - 3223'	Lime and Shale
3223 - 3238'	Lime
3238 - 3319'	Shale
3319 - 3332'	Lime and Shale
3332 - 3552'	Lime
3552 - 3562'	Lime and Shale
3562 - 3632'	Shale, Lime, Chert, Sand
3632'	RTD

FORMATION TOPS

Anhydrite	787
Hebner	3202
Toronto	3223
Douglas	3238
Brown Lime	3319
Lansing K.C.	3332
Base K.C.	3552
Conglomerate	3562
RTD	3632

SURFACE PIPE:
Set used 8 5/8", 28# pipe
© 313' w/225 sacks 50/50 Pozmix
2% Gal, 3% cc.

AFFIDAVIT

STATE OF KANSAS }
COUNTY OF BARTON } ss.

RECEIVED
STATE CORPORATION COMMISSION
AUG 25 1976
CONSERVATION DIVISION
Wichita, Kansas

Larry Curtis, of lawful age, does swear and state that the facts and statements herein contained are true and correct to the best of his knowledge.

Larry Curtis

Subscribed and sworn to before me this 23rd day of August, 1976.

Lois M. Hague
Notary Public

My Commission Expires: April 11, 1978