

ST

STATE OF KANSAS  
STATE CORPORATION COMMISSION

Form CP-4


Give All Information Completely  
Make Required Affidavit  
Mail or Deliver Report to:  
Conservation Division  
State Corporation Commission  
212 No. Market  
Wichita, Kansas

WELL PLUGGING RECORD

Stafford County. Sec. 5 Twp. 21 Rge. 13 (E) W (W)  
SE SE NW

Location as "NE/CNW/SW" or footage from lines  
Lease Owner H.C. Bennett  
Lease Name Newcombe "B" Well No. 1  
Office Address Wichita, Kansas  
Character of Well (completed as Oil, Gas or Dry Hole) \_\_\_\_\_  
Date well completed \_\_\_\_\_ 19\_\_\_\_  
Application for plugging filed \_\_\_\_\_ 19\_\_\_\_  
Application for plugging approved \_\_\_\_\_ 19\_\_\_\_  
Plugging commenced 4-29-66 \_\_\_\_\_ 19\_\_\_\_  
Plugging completed 5-2-66 \_\_\_\_\_ 19\_\_\_\_  
Reason for abandonment of well or producing formation Depleted.

NORTH

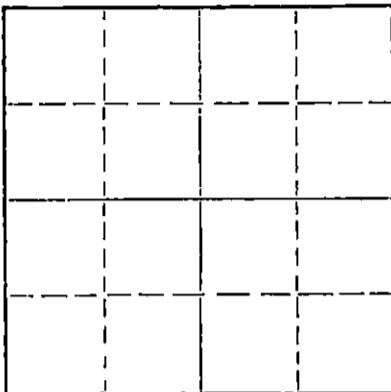

Locate well correctly on above  
Section Plat

If a producing well is abandoned, date of last production \_\_\_\_\_ 19\_\_\_\_  
Was permission obtained from the Conservation Division or its agents before plugging was commenced? yes

Name of Conservation Agent who supervised plugging of this well Archie Elving  
Producing formation \_\_\_\_\_ Depth to top \_\_\_\_\_ Bottom \_\_\_\_\_ Total Depth of Well 3629 Feet  
Show depth and thickness of all water, oil and gas formations.

OIL, GAS OR WATER RECORDS

CASING RECORD

FORMATION	CONTENT	FROM	TO	SIZE	PUT IN	PULLED OUT
				8-5/8"	212'	None
				5-1/2"	3628'	2888'

Describe in detail the manner in which the well was plugged, indicating where the mud fluid was placed and the method or methods used in introducing it into the hole. If cement or other plugs were used, state the character of same and depth placed, from \_\_\_\_\_ feet to \_\_\_\_\_ feet for each plug set.

Checked hole, sanded hole to 3400' and dumped 5 sacks of cement @ 3400' with dump bailer. Pulled 5 1/2" casing, set rock bridge from 212' to 200' and dumped 5 sacks of cement with dump bailer. Bailed fluid down and dumped 20 sacks of cement. Mudded hole to 40', set rock bridge to 30' and ran 10 sacks of cement to base of cellar.

RECEIVED  
STATE CORPORATION COMMISSION

MAY 19 1966

CONSERVATION DIVISION  
WICHITA, KANSAS

PLUGGING COMPLETE.

(If additional description is necessary, use BACK of this sheet)

Name of Plugging Contractor KNIGHT CASING PULLING COMPANY  
Address CHASE, KANSAS

STATE OF KANSAS COUNTY OF RICE, ss.  
Noel J. Knight (employee of owner) or ~~conservation operator~~ of the above-described well, being first duly sworn on oath, says: That I have knowledge of the facts, statements, and matters herein contained and the log of the above-described well as filed and that the same are true and correct. So help me God.

(Signature) Noel J. Knight  
Chase, Kansas  
(Address)

SUBSCRIBED AND SWORN TO before me this 3rd day of May, 1966

My commission expires May 20, 1968

Milton J. Volin  
Notary Public.

WELL LOG BUREAU—KANSAS GEOLOGICAL SOCIETY  
508 East Murdock, Wichita, Kansas

COPY


15-185.00444.0000

Company- PETROLEUM, INC.  
Farm- Newcombe "B" No. 1

SEC. 5 T. 21 R. 13W  
SE SE NW

Total Depth. 3629  
Comm. 10-7-51 Comp. 10-18-51  
Shot or Treated.  
Contractor. Garvey Oil  
Issued. 1-5-52

County Stafford  
KANSAS

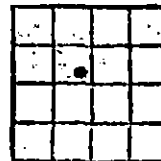

Elevation. 1901 R.B.

Production. IPP 75 BO

CASING:

8 5/8" 212' cem. w/150 sx  
5 1/2" 3628' cem. w/100 sx

Figures Indicate Bottom of Formations.

surface soil & sand	110
iron	120
surface soil	138
sand & shale	190
shale & shells	212
shale	260
sand	300
shale & shells	350
red bed	790
anhydrite	810
shale & shells	1670
lime & shale	1790
sandy lime	1975
lime & shale	2274
shale & shells	2715
lime & shale	2837
lime	3629 RTD
Total Depth	

Tops:	
Heebner	3190
Brown Lime	3305
Lansing	3317
Arbuckle	3571

RECEIVED  
STATE CORPORATION COMMISSION

APR 18 1966

CONSERVATION DIVISION  
Wichita, Kansas

*Perforations 3438-44*  
*R.T.D. 3629*