


STATE OF KANSAS  
STATE CORPORATION COMMISSION

Give All Information Completely  
Make Required Affidavit  
Mail or Deliver Report to:  
Conservation Division  
State Corporation Commission  
211 No. Broadway  
Wichita, Kansas

WELL PLUGGING RECORD

STAFFORD County. Sec. 5 Twp. 21s Rge. 13W #1 X(W)

Location as "NE/CNW/SW" or footage from lines NE NE NW  
Lease Owner PETROLEUM, INC.  
Lease Name NEWCOMBE "B" Well No. 3  
Office Address ROUTE 2, GREAT BEND, KANSAS  
Character of Well (completed as Oil, Gas or Dry Hole) DRY HOLE  
Date well completed APRIL 28, 19 62  
Application for plugging filed MAY 7, 19 62  
Application for plugging approved MAY 16, 19 62  
Plugging commenced MAY 16, 19 62  
Plugging completed MAY 24, 19 62  
Reason for abandonment of well or producing formation NO PRODUCIBLE FORMATIONS.

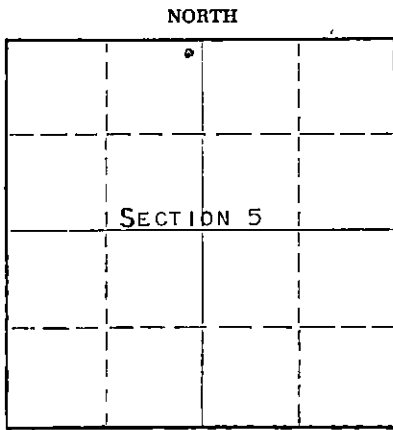

Locate well correctly on above  
Section Plat

If a producing well is abandoned, date of last production NONE 19  
Was permission obtained from the Conservation Division or its agents before plugging was commenced? YES

Name of Conservation Agent who supervised plugging of this well W. L. LACKAMP, JR.  
Producing formation KANSAS CITY Depth to top 3301 Bottom 3522 Total Depth of Well 3621 Feet  
Show depth and thickness of all water, oil and gas formations.

OIL, GAS OR WATER RECORDS

CASING RECORD

FORMATION	CONTENT	FROM	TO	SIZE	PUT IN	PULLED OUT
KANSAS CITY	WATER & LITTLE OIL	3452	3462	8-5/8"	231'	NONE
		3423	3428	4-1/2"	3600'	1356'
		3302	3308			

Describe in detail the manner in which the well was plugged, indicating where the mud fluid was placed and the method or methods used in introducing it into the hole. If cement or other plugs were used, state the character of same and depth placed, from feet to feet for each plug set.

PLUGGED BACK T.D. 3528'

FILLED HOLE WITH CRUSHED ROCK FROM 3528'-3275'. PLACED 4 SACKS CEMENT ONTO CRUSHED ROCK TO 3230'. MUDDED UP WITH HEAVY MUD TO 200' AND BUILT SOLID ROCK BRIDGE TO 185'. RAN 10 SACKS CEMENT AT 185', CEMENT LEAKED. GLOBE CEMENTING COMPANY SQUEEZED WITH 10 SACKS JELL AND 75 SACKS CEMENT. LET SET OVER NIGHT. CEMENT HAD SETTLED. FILLED HOLE TO BASE OF WELL CELLAR WITH 7 SACKS CEMENT.

NOTE: WASH DOWN, ORIGINALLY DRILLED AS NEWCOMBE #1 BY GABBERT-JONES DRILLING COMPANY, COMPLETED AS DRY HOLE AUGUST 2, 1950. GABBERT-JONES FILED DRILLERS WELL LOG.

RECEIVED  
STATE CORPORATION COMMISSION

JUN 15 1962

CONSERVATION DIVISION  
Wichita, Kansas

(If additional description is necessary, use BACK of this sheet)

Name of Plugging Contractor GARVEY DRILLING COMPANY  
Address ROUTE 2, GREAT BEND, KANSAS

6-15-1962

STATE OF KANSAS, COUNTY OF BARTON, ss.  
DON SEARLE (employee of owner) or (~~owner~~) of the above-described well, being first duly sworn on oath, says: That I have knowledge of the facts, statements, and matters herein contained and the log of the above-described well as filed and that the same are true and correct. So help me God. DON SEARLE, DIST. PROD. SUPT.

(Signature) Don Searle  
ROUTE 2, GREAT BEND, KANSAS  
(Address)

SUBSCRIBED AND SWORN TO before me this 14TH day of JUNE, 19 62

My commission expires APRIL 14, 1963.

Arthur J. Miles  
Notary Public.

