


STATE OF KANSAS  
STATE CORPORATION COMMISSION

WELL PLUGGING RECORD

Give All Information Completely  
Make Required Affidavit  
Mail or Deliver Report to:  
Conservation Division  
State Corporation Commission  
800 Bitting Building  
Wichita, Kansas

Stafford County. Sec. 5 Twp. 21 Rge. (E) 13 (W)  
Location as "NE/CNW $\frac{1}{4}$ /SW $\frac{1}{4}$ " or footage from lines NE NE SW  
Lease Owner Westgate-Greenland Oil Company  
Lease Name Newcombe Well No. 1  
Office Address 1009 Central Building, Wichita 2, Kansas  
Character of Well (completed as Oil, Gas or Dry Hole) dry hole  
Date well completed November 17, 1951 19  
Application for plugging filed (orally) November 17, 1951 19  
Application for plugging approved " November 17, 1951 19  
Plugging commenced November 17, 1951 19  
Plugging completed November 17, 1951 19  
Reason for abandonment of well or producing formation

NORTH

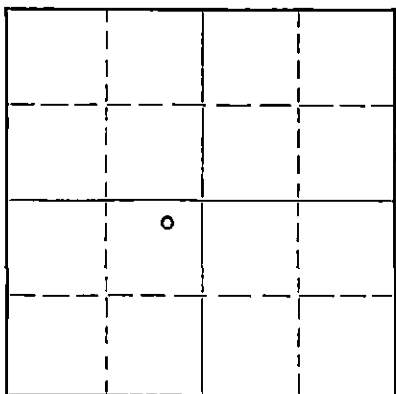

Locate well correctly on above  
Section Plat

If a producing well is abandoned, date of last production 19  
Was permission obtained from the Conservation Division or its agents before plugging was commenced? yes

Name of Conservation Agent who supervised plugging of this well  
Producing formation Depth to top Bottom Total Depth of Well Feet  
Show depth and thickness of all water, oil and gas formations.

OIL, GAS OR WATER RECORDS

CASING RECORD

Formation	Content	From	To	Size	Put In	Pulled Out
Surface		0	220	8 5/8"	220	none

Describe in detail the manner in which the well was plugged, indicating where the mud fluid was placed and the method or methods used in introducing it into the hole. If cement or other plugs were used, state the character of same and depth placed, from feet to feet for each plug set.

Filled hole with heavy mud from total depth to 210 feet  
Set plug and ran 15 sacks cement, filling hole to 180 feet  
Filled hole with heavy mud and set plug at 35 feet,  
Ran 10 sacks cement to cellar.

11-24-51

(If additional description is necessary, use BACK of this sheet)

Correspondence regarding this well should be addressed to Westgate-Greenland Oil Company  
Address 1009 Central Building, Wichita 2, Kansas

STATE OF Kansas, COUNTY OF Sedgwick, ss.

G. E. Bitler (employee of owner) or (owner or operator) of the above-described well,  
being first duly sworn on oath, says: That I have knowledge of the facts, statements, and matters herein contained and the log of the above-described well as filed and that the same are true and correct. So help me God.

(Signature) G. E. Bitler  
1009 Central Building, Wichita 2, Kansas  
(Address)

SUBSCRIBED AND SWORN to before me this 23rd day of November, 1951

Esther Russell  
Notary Public.

My commission expires May 25, 1953.

PLUGGING  
FILE SEC 5 T 21 R 13W  
BOOK PAGE 125 LINE 6

## DRILLER'S LOG

COMPANY: Westgate-Greenland Oil Company  
 CONTRACTOR: Jackson Drilling Corporation  
 FARM: Newcombe No. 1  
 LOCATION: NE NE SW Sec. 5-21-13W  
 Stafford County, Kansas  
 COMMENCED: November 8, 1951  
 COMPLETED: November 17, 1951  
 ELEVATION: 1906 DF.

0	to	90	Sand W/clay streaks
90	to	128	Pyritic sand
128	to	145	Shale
145	to	152	Pyritic sand
152	to	170	Sand
170	to	220	Pyritic Sand and shale
220	to	325	Shale
325	to	786	Red bed and shale
786	to	807	Anhydrite
807	to	1270	Shale and shells
1270	to	1570	Shale and shells W/salt
1570	to	1650	Shale and lime
1650	to	1770	Lime
1770	to	2105	Lime and shale
2105	to	2125	Lime
2125	to	2745	Lime and shale
2745	to	2782	Lime W/shale breaks
2782	to	3050	Lime and shale
3050	to	3100	Lime
3100	to	3128	Shale
3128	to	3187	Lime and shale
3187	to	3278	Lime
3278	to	3319	Shale and lime
3319	to	3331	Brown Lime
3331	to	3552	Lansing lime
3552	to	3601	Lime and shale
3601	to	3632	Conglomerate
		3632	T. D.

Set 220 feet of 8 5/8" surface 24# pipe. Cemented with 175 sacks cement and 2 sacks calcium chloride.

Tops: Anhydrite 786. Heebner 3199. Brown, <sup>DF</sup>Lime 3316. <sup>DF</sup>Lansing 3329. B. K/C 3556. Cherty Conglomerate 3577.

No drill stem tests. No schlumberger.

Dry - plugged - abandoned.

C E R T I F I C A T E

I, Harold A. Burt, do hereby certify that the above and foregoing is a true and correct copy of log of Newcombe #1, NE NE SW Section 5-21-13W, Stafford County, Kansas, as reflected by files of the Jackson Drilling Corporation.

*Harold A. Burt*  
Harold A. Burt

Subscribed and sworn to before me a Notary Public, within and for Sedgwick County, Kansas, this 21st day of November, 1951.

*Esther Russell*  
Notary Public

My commission expires May 25, 1953.

**PLUGGING**  
FILE SEC 5 T21 R13W  
BOOK PAGE 25 LINE 6