

STATE OF KANSAS  
STATE CORPORATION COMMISSION


WELL PLUGGING RECORD

OR  
FORMATION PLUGGING RECORD

Strike out upper line  
when reporting plug-  
ging off formations.

Give All Information Completely  
Make Required Affidavit  
Mail or Deliver Report to:  
Conservation Division  
State Corporation Commission  
800 Bittling Building  
Wichita, Kansas

NORTH

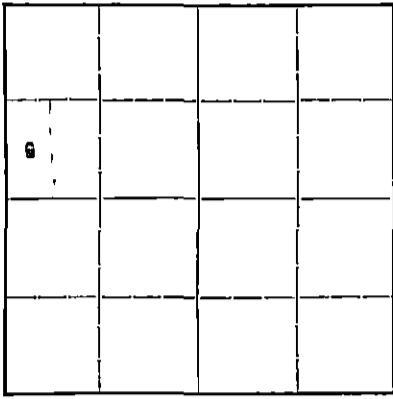

Locate well correctly on above  
Section Plat

Stafford County. Sec. 3 Twp. 21 Rge. 13 (E) 13 (W)  
Location as "NE $\frac{1}{4}$ NW $\frac{1}{4}$ SW $\frac{1}{4}$ " or footage from lines. W/2 SW/4 NW/4  
Lease Owner The Atlantic Refining Co.  
Lease Name Jung Well No. 1  
Office Address Box 17, Great Bend, Kansas.  
Character of Well (completed as Oil, Gas or Dry Hole) Dry Hole  
Date, well completed. ----- 19\_\_\_\_\_  
Application for plugging filed. June, 6, 1941.  
Application for plugging approved. June, 6, (by local agent) 1941.  
Plugging Commenced. June, 6, 1941.  
Plugging Completed. June, 11, 1941.  
Reason for abandonment of well or producing formation. Dry Hole

If a producing well is abandoned, date of last production. ----- 19\_\_\_\_\_  
Was permission obtained from the Conservation Division or its agents before plugging was com-  
menced? Yes

Name of Conservation Agent who supervised plugging of this well C.T. Alexander  
Producing formation. None Depth to top. ----- Bottom. ----- Total Depth of Well 3584 Feet  
Show depth and thickness of all water, oil and gas formations.

OIL, GAS OR WATER RECORDS

CASING RECORD


Formation	Content	From	To	Size	Put In	Pulled Out
<u>Arbuckle</u>	<u>Slight Oil Show</u>	<u>3560</u>	<u>3581</u>	<u>8 5/8</u>	<u>252</u>	<u>None</u>
<u>"</u>	<u>Water</u>	<u>3581</u>	<u>3584</u>	<u>5 1/2</u>	<u><del>3551</del> 3560</u>	<u>2750</u>
<u>Kansas City</u>	<u>Barren</u>	<u>3267</u>	<u>3560</u>			

Describe in detail the manner in which the well was plugged, indicating where the mud fluid was placed and the method or methods used in introducing it into the hole. If cement or other plugs were used, state the character of same and depth placed, from ----- feet to ----- feet for each plug set.

Casing Gun Perforated 3314 to 3458

Plugged with cement, 25 sacks 3584 to 3314  
Plugged with mud 3314 to 225  
Plugged with cement, 10 sks. 225 to 200  
Plugged with mud 200 to 18  
Plugged with cement, 10 sks. 18 to 6 (bottom cellar)

PLUGGING  
FILE SEC 3-1-21-R-13W  
BOOK PAGE 140 LINE 36

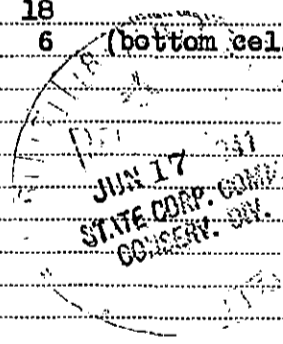

(If additional description is necessary, use BACK of this sheet)

Correspondence regarding this well should be addressed to The Atlantic Refining Co.  
Address Box 17, Great Bend, Kansas.

STATE OF KANSAS, COUNTY OF BARTON, ss.

P.B. Edmondson (employee of owner) or (owner or operator) of the above-described well,  
being first duly sworn on oath, says: That I have knowledge of the facts, statements, and matters herein contained and the log of the above-  
described well as filed and that the same are true and correct. So help me God.

(Signature) P.B. Edmondson

Box 17, Great Bend, Kansas.  
(Address)


SUBSCRIBED AND SWORN to before me this 16th day of June, 19 41.

My commission expires Oct 28, 1944

H.C. Colegrove  
Notary Public.



640 Acres  
N KS-4973

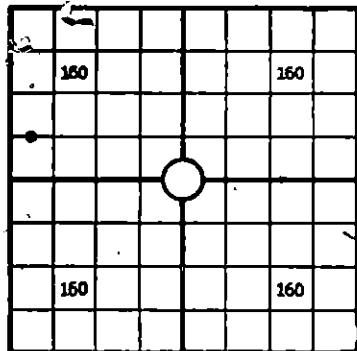

Locate Well Correctly

K A N S A S WELL RECORD AND PLUGGING REPORT

~~MAKING CORPORATION, OKLAHOMA CITY, OKLAHOMA~~  
 COUNTY Stafford, SEC. 3, TWP. 21S, RGE. 13W  
 COMPANY OPERATING The Atlantic Refining Company  
 OFFICE ADDRESS 510 Beacon Building, Tulsa, Oklahoma  
 FARM NAME JUNG WELL NO. 1  
 DRILLING STARTED 4-14, 1941, DRILLING FINISHED 5-20, 1941  
 DATE OF FIRST PRODUCTION DRY COMPLETED \_\_\_\_\_  
 WELL LOCATED Q.W/2  $\frac{1}{4}$  SW  $\frac{1}{4}$  NW \_\_\_\_\_, North of South  
 Line and \_\_\_\_\_ ft. East of West Line of Quarter Section  
 Elevation (Relative to sea level) DERRICK FLOOR 1884 GROUND \_\_\_\_\_  
 CHARACTER OF WELL (Oil, gas or dryhole) DRY HOLE

OIL OR GAS SANDS OR ZONES

Name	From	To	Name	From	To
1 Lansing	3287		4		
2 Arbuckle	3556 $\frac{1}{2}$	3584	5		
3			6		

WATER SANDS

Name	From	To	Water level	Name	From	To	Water level
1				4			
2				5			
3				6			

CASING RECORD

Size	Wt.	Thds.	Make	Amount Set		Amount Pulled		Packer Record			
				Ft.	In.	Ft.	In.	Size	Length	Depth Set	Make
8-5/8	32	8V	SH	252		None					
5-1/2	15	8R	Pittsburg	3560		2750'					

Liner Record: Amount \_\_\_\_\_ Kind \_\_\_\_\_ Top \_\_\_\_\_ Bottom \_\_\_\_\_

CEMENTING AND MUDDING

Size	Amount Set		Sacks Cement	Chemical		Method of Cementing	Amount	Mudding Method	Results (See Note)
	Ft.	In.		Gal.	Make				
8-5/8	252		125						
5-1/2"	3560		125			PIGGING			
						3 21.13.00			
						BOC	140 LINE 3.6		

Note: What method was used to protect sands when outer strings were pulled? \_\_\_\_\_

NOTE: Were bottom hole plugs used? \_\_\_\_\_ If so, state kind, depth set and results obtained \_\_\_\_\_

TOOLS USED

Rotary tools were used from 0 feet to 3571 feet, and from \_\_\_\_\_ feet to \_\_\_\_\_ feet  
 Cable tools were used from 3571 feet to 3584 feet, and from \_\_\_\_\_ feet to \_\_\_\_\_ feet  
 Type Rig \_\_\_\_\_

PRODUCTION DATA

**DRY HOLE**  
 Production first 24 hours \_\_\_\_\_ bbls. Gravity \_\_\_\_\_, Emulsion \_\_\_\_\_ per cent., Water \_\_\_\_\_ per cent  
 Production second 24 hours \_\_\_\_\_ bbls. Gravity \_\_\_\_\_, Emulsion \_\_\_\_\_ per cent., Water \_\_\_\_\_ per cent  
 If gas well, cubic per 24 hours \_\_\_\_\_ Rock Pressure: Lbs. per square inch \_\_\_\_\_

I, the undersigned, being first duly sworn upon oath, state that this well record is true, correct and complete according to the records of this office and to the best of my knowledge and belief.

THE ATLANTIC REFINING COMPANY  
 By: \_\_\_\_\_  
 Name and title of representative of company  
J. M. Johnson, Asst. to Div. Supt.

Subscribed and sworn to before me this 1st day of August, 1941  
 My Commission expires November 13, 1943

*Myrtle Hansen*  
 Notary Public

## FORMATION RECORD

Give detailed description and thickness of all formations drilled through and contents of sand, whether dry, water, oil or gas

Formation	Top	Bottom	Formation	Top	Bottom
Surface	0	257			
Shale	257	270			
Shale and shells	270	740			
Anhydrite	740	780			
Shale and lime shells	780	1030			
Shale and lime shells	1030	1245			
Shale, shells, salt	1245	1490			
Shale	1490	1565			
Anhydrite	1565	1610			
Lime	1610	1745			
Broken lime	1745	1805			
Shale and lime shells	1805	1922			
Lime, shale	1922	1935			
Sand	1935	1956			
Lime, shale	1956	2008			
Shale	2008	2068			
Broken lime	2068	2122			
Lime	2122	2140			
Broken lime	2140	2251			
Shale and shells	2251	2314			
Shale	2314	2356			
Lime and shale	2356	2645			
Lime	2645	2735			
Shale, lime	2735	2800			
Shale and lime shells	2800	2885			
Shale, lime	2885	3000			
Shale	3000	3030			
Broken lime	3030	3078			
Lime	3078	3115			
Lime and shale	3115	3271			
Lime	3271	3518			
Shale, chert	3518	3538			
Lime	3538	3548			
Shale	3548	3558			
Lime and shale	3558	3566			
Lime	3566	3584 TD			
HOLE FULL OF WATER PLUGGED BACK TO		3497			
PLUGGED AND ABANDONED JUNE 11, 1911					