


STATE OF KANSAS
STATE CORPORATION COMMISSION

WELL PLUGGING RECORD

Give All Information Completely
Make Required Affidavit
Mail or Deliver Report to:
Conservation Division
State Corporation Commission
212 No. Market
Wichita, Kansas

Stafford County, Sec. 35 Twp. 21 Rge. (E) 12 (W)

Location as "NE/CNWSW" or footage from lines. Approx. NW SE NW
Lease Owner Lee Phillips Oil Company
Lease Name Sittner Well No. 5
Office Address 1532 Wichita Plaza, Wichita, Kansas
Character of Well (completed as Oil, Gas or Dry Hole) SWD
Date well completed October 16 19 58
Application for plugging filed June 17 19 69
Application for plugging approved 19
Plugging commenced June 27 19 69
Plugging completed July 1 19 69
Reason for abandonment of well or producing formation no longer needed

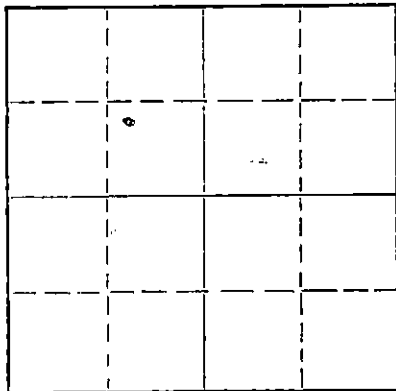

Locate well correctly on above Section Plat

If a producing well is abandoned, date of last production 19
Was permission obtained from the Conservation Division or its agents before plugging was commenced? YES

Name of Conservation Agent who supervised plugging of this well Ralph Warren
Producing formation Depth to top Bottom Total Depth of Well 4010 Feet
Show depth and thickness of all water, oil and gas formations.

OIL, GAS OR WATER RECORDS

CASING RECORD

FORMATION	CONTENT	FROM	TO	SIZE	PUT IN	PULLED OUT
		0	267'	8 5/8"	267'	none
		0	3800'	5 1/2"	3800'	2603'

Describe in detail the manner in which the well was plugged, indicating where the mud fluid was placed and the method or methods used in introducing it into the hole. If cement or other plugs were used, state the character of same and depth placed, from feet to feet for each plug set.

Set plug at 3600'. Sand from 3600' to 3560'. Run 5 sacks of cement from 3560' to 3530'.
Set plug at 260', set 10' rock bridge and ran 5 sacks of cement. Bailed out water. Ran 20 sacks of cement from 250' to 170'. Filled hole with mud to 40', set rock bridge and capped hole with 10 sacks of cement.

RECEIVED
STATE CORPORATION COMMISSION
JUL 16 1969
CONSERVATION DIVISION
Wichita, Kansas

(If additional description is necessary, use BACK of this sheet)
Name of Plugging Contractor PIPE PULLERS, INC.
Address Box 486, Ellinwood, Kansas

STATE OF Kansas COUNTY OF Barton ss.
Evelyn Roth (employee of owner) or (owner or operator) of the above-described well, being first duly sworn on oath, says: That I have knowledge of the facts, statements, and matters herein contained and the log of the above-described well as filed and that the same are true and correct. So help me God.

(Signature) Evelyn Roth
Ellinwood, Kansas (Address)

SUBSCRIBED AND SWORN TO before me this 8th day of July, 19 69

George A Meyer
Notary Public.

My commission expires Feb. 10, 1971

15.185.13151.0000

E. H. Adair Oil Company
1005 East Second Street
Wichita 7, Kansas.

RECEIVED
STATE CORPORATION COMMISSION
JUN 18 1969
CONSERVATION DIVISION
Wichita, Kansas

E. H. Adair Oil Company, and
Lee Phillips Oil Company,
No. 5 - Sittner.
Approx. NW SE NW
(830 feet from East line, and
1090 feet from South line) of
Northwest Quarter of
Section 35, Twp. 21 S., Range 12 W.,
Stafford County, Kansas.

Comm.: 10-2-58
Comp.: 10-16-58
Contractor:
Raymond Oil Company,
Rig No. 2
8-5/8 in. s/csg. @ 267 ft.
w/225 sax.
5-1/2 in. @ 3800 feet,
w/200 sax.

Elev.: 1834 K.B.

Figures indicate bottoms of formations.

Sand	to	175
Redbeds		250
Shale		620
Anhydrite		632
Shale		1420
Shale & lime		3000
Lime		3101
Black shale		3106
Lime		3110
Shale & lime		3129
Lime		3134
Shale		3233
Lime		3236
Shale		3255

Lime	to	3295
Porous lime		3297
Lime		3329
Porous lime		3333
Lime		3447
Porous lime		3450
Lime		3507
Sandy shale		3523
Conglomerate		3538
Shaley chert		3565
Shale		3610
Dolomite, show of oil		3680
Dolomite		4010
R. T. D.		4010

Tops

HEEBNER SHALE	3101 (-1267)
DOUGLAS SHALE	3134 (-1300)
BROWN LIME	3233 (-1399)
LANSING - K.C.	3255 (-1421)
CHERTY CONGLOMER-	
ATR	3523 (-1689)
VIOLA	3538 (-1704)
SIMPSON	3565 (-1731)
ARBUCKLE DOLOMITE	3610 (-1776)

RECEIVED
STATE CORPORATION COMMISSION
JUN 18 1969
CONSERVATION DIVISION
Wichita, Kansas

Certified correct:

K. W. Johnson
K. W. Johnson - Geologist.