

STATE OF KANSAS
STATE CORPORATION COMMISSION

WELL PLUGGING RECORD

Give All Information Completely
Make Required Affidavit
Mail or Deliver Report to:
Conservation Division
State Corporation Commission
800 Bitting Building
Wichita, Kansas

Stafford County, Sec. 35 Twp. 21 Rge. 12 (W)

Location as "NE/CNWxSWx" or footage from lines NE SE SW

Lease Owner Shawver-Armour, Inc.

Lease Name Hitz Well No.

Office Address 817 Central Building

Character of Well (completed as Oil, Gas or Dry Hole) Dry Hole

Date well completed 5-9-55 19

Application for plugging filed 5-9-55 19

Application for plugging approved 5-9-55 19


Plugging commenced 5-9-55 19

Plugging completed 5-9-55 19

Reason for abandonment of well or producing formation Dry Hole

If a producing well is abandoned, date of last production none 19

Was permission obtained from the Conservation Division or its agents before plugging was commenced? Warren H Horner Box 207, Great Bend

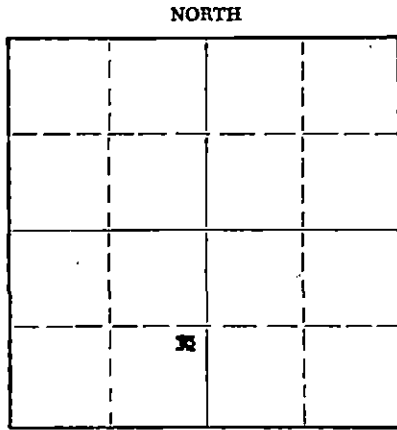

Locate well correctly on above Section Plat

Name of Conservation Agent who supervised plugging of this well

Producing formation none Depth to top Bottom Total Depth of Well 3637 Feet

Show depth and thickness of all water, oil and gas formations.

OIL, GAS OR WATER RECORDS

CASING RECORD

FORMATION	CONTENT	FROM	TO	SIZE	PUT IN	PULLED OUT
Surface				8-5/8	226'	None

Describe in detail the manner in which the well was plugged, indicating where the mud fluid was placed and the method or methods used in introducing it into the hole. If cement or other plugs were used, state the character of same and depth placed, from feet to feet for each plug set.

3627 - 225' fill w/ heavy mud
225' No. 1 Plug 1/3 sx hulls and Halliburton Plug
20 sx cement thru drill pipe
35' No. 2 Plug 1/3 sx Hulls and Halliburton Plug. 10 sx cement to Base of cellar.

(If additional description is necessary, use BACK of this sheet)

Name of Plugging Contractor Shawver-Armour, Inc.

Address 817 Central Building, Wichita, Kansas

STATE OF Kansas, COUNTY OF Sedgwick, ss.
James Armour (employee of owner) or (owner or operator) of the above-described well, being first duly sworn on oath, says: That I have knowledge of the facts, statements, and matters herein contained and the log of the above-described well as filed and that the same are true and correct. So help me God.

(Signature) James Armour
817 Central Building, Wichita, Kansas
(Address)

SUBSCRIBED AND SWORN to before me this 16 day of May, 19 55

My commission expires May 30, 1957

Rosemary Purose
Notary Public.

RECEIVED
STATE CORPORATION COMMISSION
MAY 17 1955
CONSERVATION DIVISION
Wichita, Kansas

PLUGGING
SEC 35 T 21 R 12W
BOOK PAGE 118 LINE 32

DRILLING LOG

COMPANY: Shawver-Armour, Inc. LOCATION: NB 38 CW
 CONTRACTOR: Shawver-Armour, Inc. Sec. 35-219-12N
 Stafford County
 PARK NAME: HITZ #1 ELEVATION: 1833 KB
 COMMENCED: May 1, 1955
 COMPLETED: May 8, 1955

LOGGING RECORD
 6-5/8" 227' w/230 sq. cas.

<u>FORMATION</u>	<u>FROM</u>	<u>TO</u>	<u>TONS</u>
Surface Hole	0	227	Heebner 3110 -1277
Red Bed w/ Shale-Shale		678	Toronto 3129 -1296
Line & Shale		2561	Brown Line 3244 -1141
Sandy Shale w/Line		2975	Lansing 3260 -1427
Line & Shale		3245	Conglomerate 3546 -1719
Shale & Brown Line		3260	HTD 3637 -1804
Lan. K.C. Line		3277	
Line		3321	
Line & Shale		3432	
Line		3505	
Line & Shale		3637	HTD

STATE OF KANSAS)
) **
 BEDFORD COUNTY)

I, James Armour, do hereby certify that the above is a true and correct copy of the log on the above captioned well, as shown on the daily drilling reports.

SHAWVER ARMOUR, INC.

By: James M. Armour
 James Armour, Sec'y.-Treas.

Subscribed and sworn to before me this 11 day of May, 1955.

Leslie Penrose
 Notary Public

My commission expires Nov 30, 1957.

PLUGGING
 SEC 35-219-12N
 W/230 sq. cas. LINE 22'

RECEIVED
 STATE CORPORATION COMMISSION
 MAY 17 1955
 CONSERVATION DIVISION
 Wichita, Kansas