


WELL PLUGGING RECORD

Give All Information Completely
Make Required Affidavit
Mail or Deliver Report to:
Conservation Division
State Corporation Commission
800 Blitting Building
Wichita, Kansas

Stafford County, Sec. 35 Twp. 21 Rge. 12 (E) W (W)
Location as "NE/CNW $\frac{1}{4}$ SW $\frac{1}{4}$ " or footage from lines SW-SE-SW
Lease Owner PETROLEUM, Inc.
Lease Name HITZ "B" Well No. 1
Office Address 305 East Third Street, Wichita, Kansas
Character of Well (completed as Oil, Gas or Dry Hole) Dry Hole
Date well completed June 19 19.53
Application for plugging filed June 23 19.53
Application for plugging approved June 25 19.53
Plugging commenced June 25 19.53
Plugging completed July 7 19.53
Reason for abandonment of well or producing formation
No producible shows.
If a producing well is abandoned, date of last production 19.
Was permission obtained from the Conservation Division or its agents before plugging was commenced? Yes

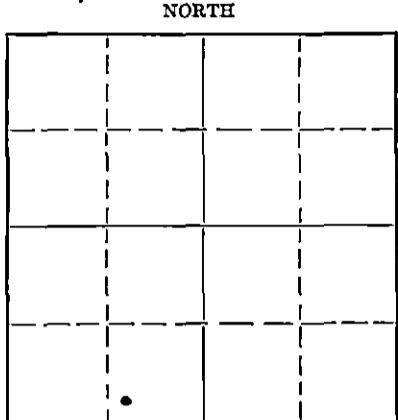

Locate well correctly on above Section Plat

Name of Conservation Agent who supervised plugging of this well M. A. Rives
Producing formation Arbuckle Depth to top 3,609' Bottom Total Depth of Well 3,613' Feet
Show depth and thickness of all water, oil and gas formations.

OIL, GAS OR WATER RECORDS

CASING RECORD

Formation	Content	From	To	Size	Put In	Pulled Out
Arbuckle	Water & Oil	3,610'	3,628'	8-5/8"	249'	None
				5-9/16"	3,610'	263'

Describe in detail the manner in which the well was plugged, indicating where the mud fluid was placed and the method or methods used in introducing it into the hole. If cement or other plugs were used, state the character of same and depth placed, from feet to feet for each plug set.

(Rotary total depth: 3,613'; Drilled to 3,628' with cable tools.)

Plugged back with crushed rock from 3,628' to 3,600' and placed five sacks cement on top of rock bridge. Mudded up to 240' and placed a rock bridge from 240' to 235'. Placed 20 sacks cement on top of rock bridge and mudded up to 35'. Placed rock bridge from 35' to 30' and filled hole with 10 sacks cement to base of cellar.

RECEIVED
STATE CORPORATION COMMISSION
JUL 25 1953
CONSERVATION DIVISION
Wichita, Kansas

(If additional description is necessary, use BACK of this sheet)

Correspondence regarding this well should be addressed to PETROLEUM, Inc.
Address Rural Route 2, Great Bend, Kansas

STATE OF Kansas, COUNTY OF Sedgewick, ss.
Paul B. Shivel (employee of owner) or (owner) of the above-described well,
being first duly sworn on oath, says: That I have knowledge of the facts, statements, and matters herein contained and the log of the above-described well as filed and that the same are true and correct. So help me God.
(Signature) Paul B. Shivel
Rural Route 2, Great Bend, Kansas (Address)

SUBSCRIBED AND SWORN to before me this 10th day of July, 19.53

My commission expires October 13, 1954

Notary Public.

PLUGGING
FILE SEC 35 T 21 R 12W
BOOK PAGE 116 LINE 4

DRILLER'S LOG HITZ 'B' #1

Petroleum, Inc., Operator
 Garvey Drilling Company, Contractor
 Drilling Commenced: June 4, 1953
 Drilling Completed: June 13, 1953

Section 35, Twp. 21S, Rge. 12W
 Location: SW SE SW
 County: Stafford County, Kansas
 R.T.D.: 3613'
 Production: D & A

Casing Record: 8 5/8" @ 249' w/200 sax
 5 1/2" @ 3610' w/75 sax

Figures below indicate bottom of formation:

80 Sand
 210 Sand & Red Rock
 628 Red Rock
 653 Anhydrite
 1130 Shale & Shells
 1525 Shale, Salt & Shells
 1785 Lime
 2600 Lime & Shale
 2730 Shale
 2980 Lime & Shale
 3050 Sandy Lime
 3124 Lime
 3192 Lime & Shale
 3275 Shale
 3533 Lime
 3567 Viola
 3611 Shale
 3613 Lime
 3613' R.T.D.

Tops:
 Heebner: 3119 (-1276)
 Brown Lime: 3250 (-1407)
 Lansing: 3273 (-1430)
 Arbuckle: 3609 (-1766)

I hereby certify that this is a true and correct log of the above mentioned well.

PETROLEUM, INC.

RECEIVED
 STATE CORPORATION COMMISSION

JUL 25 1953

CONSERVATION DIVISION
 Wichita, Kansas

STATE OF KANSAS)
 COUNTY OF SEDGWICK)

SS:

By WW Fish

PLUGGING
 FILE SEC SE 21 12W
 BOOK PAGE 110 LINE 4

Subscribed to and sworn to before me, a Notary Public, this 24th day of June, 1953.

Charlotte Jones
 Notary Public

My commission expires: October 13, 1954.