


STATE OF KANSAS
STATE CORPORATION COMMISSION

Form CP-4

WELL PLUGGING RECORD

Give All Information Completely
Make Required Affidavit
Mail or Deliver Report to:
Conservation Division
State Corporation Commission
212 No. Market
Wichita, Kansas

NORTH

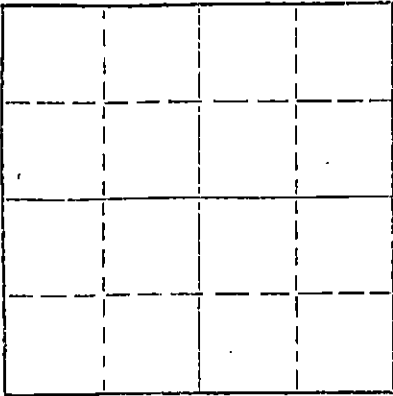

Locate well correctly on above
Section Plat

Stafford County, Sec. 35 Twp. 21S Rge. 12 (E) (W) X

Location as "NE/CNW/SW" or footage from lines Center N 1/2 NE NE S 1/4

Lease Owner Chief Drilling Company, Inc.

Lease Name Hitz Well No. D-2

Office Address P. O. Box 797 Great Bend, Kansas

Character of Well (completed as Oil, Gas or Dry Hole)

Date well completed 19 69

Application for plugging filed 4-1 19 69

Application for plugging approved 4-2 19 69

Plugging commenced 4-4 19 69

Plugging completed 4-20 19 69

Reason for abandonment of well or producing formation

If a producing well is abandoned, date of last production 19

Was permission obtained from the Conservation Division or its agents before plugging was commenced? Yes

Name of Conservation Agent who supervised plugging of this well Ralph Warren

Producing formation Depth to top Bottom Total Depth of Well 3631 Feet

Show depth and thickness of all water, oil and gas formations.

OIL, GAS OR WATER RECORDS

CASING RECORD

FORMATION	CONTENT	FROM	TO	SIZE	PUT IN	PULLED OUT
				8 5/8	240	None
				4 1/2	None	1639
RECEIVED STATE CORPORATION COMMISSION APR 29 1969 CONSERVATION DIVISION Wichita, Kansas						

Describe in detail the manner in which the well was plugged, indicating where the mud fluid was placed and the method or methods used in introducing it into the hole. If cement or other plugs were used, state the character of same and depth placed, from feet to feet for each plug set.

Moved in. Sanded to 3500'. Dumped 4 sacks of cement. Cleaned out cellar. Working pipe.

Measured in bridge at 1560'. Spudded on bridge. Lost sand pump in hole. Run sand pump to pump out bridge at 1560' and fished out pump.

Pumped on bridge at 1560' - pumped out 30' - 50'. Pumping on bridge. Spudded 35'. Spudding and pumping on bridge and measured bridge at 1750'. Dumped 4 sacks of cement at 1750'. Shot pipe at 1720' and 1650'. Pulling pipe.

Pushed plug to 230'. Set rock bridge and dumped 10 sacks of cement.

Bailed out hole. Dumped 15 sacks of cement. Mudded hole and rock bridge. Capped well with 10 sacks of cement.

(If additional description is necessary, use BACK of this sheet)

Name of Plugging Contractor Forbes Casing Pulling Company, Inc.

Address P. O. Box 221 Great Bend, Kansas 67530

STATE OF Kansas, COUNTY OF Barton, ss.

James W. Rockhold (employee of owner) or (owner or operator) of the above-described well, being first duly sworn on oath, says: That I have knowledge of the facts, statements, and matters herein contained and the log of the above-described well as filed and that the same are true and correct. So help me God.

(Signature) James W. Rockhold

P. O. Box 221 Great Bend, Kansas (Address)

SUBSCRIBED AND SWORN TO before me this 24 day of April, 19 69

My commission expires May 27, 1969

Notary Public.

COPY

WELL LOG BUREAU - KANSAS GEOLOGICAL SOCIETY

508 East Murdock,

Wichita, Kansas

Company. PETROLEUM, INC.

Farm. Hitz "D"

No. 2

SEC.

35

T.

21

R. 12W

C N/2 NE NE SW

Total Depth. 3631

Comm. 6-6-55

Comp. 6-15-55

Shot or Treated.

Contractor. Garvey Drilling Co.

Rascd. 9-10-55

County. Stafford

KANSAS



CASING:

8 5/8 @ 240' w/ 200 sq. cmt.
 4 1/2 @ 3629' w/ 75 sq. cmt.

Elevation. 1829 DF

Production. 466 BOPD

Figures indicate Bottom of Formations.

sand, clay & gravel	155
red bed & shells	240
red bed, shale & shells	613
anhydrite	635
shale & shells	1105
shale & sand	1315
shale & shells	1440
lime & shale	2185
shale & shells	2410
lime & shale	3124
shale & shells	3155
lime & shale	3242
lime	3508
cherty lime	3534
lime	3631
Total Depth	

TOPS:

Heebner	3091
Toronto	3111
Douglas	3128
Brown lime	3222
Lansing	3242
Viola	3503
Simpson	3531
Arbuckle	3576

RECEIVED
 STATE CORPORATION COMMISSION
 APR 3 1969
 CONSERVATION DIVISION
 Wichita, Kansas