

STATE OF KANSAS
STATE CORPORATION COMMISSION

Form CP-4


Give All Information Completely
Make Required Affidavit
Mail or Deliver Report to:
Conservation Division
State Corporation Commission
212 No. Market
Wichita, Kansas

WELL PLUGGING RECORD

Stafford County, Sec. 35 Twp. 21 Rge. (E) 12 (W)

Location as "NE/CNW/SW" or footage from lines NW/4
Lease Owner Lee Phillips Oil Company
Lease Name Sittner Well No. 3
Office Address 1532 Wichita Plaza, Wichita, Kansas
Character of Well (completed as Oil, Gas or Dry Hole) oil
Date well completed June 17 19 69
Application for plugging filed June 17 19 69
Application for plugging approved June 18 19 69
Plugging commenced June 20 19 69
Plugging completed June 20 19 69
Reason for abandonment of well or producing formation depleted

NORTH

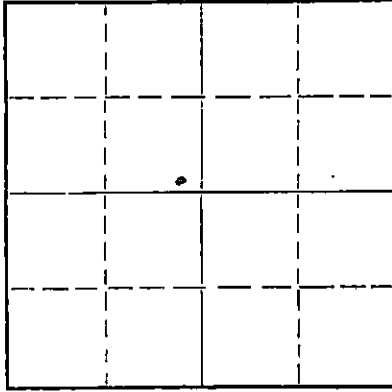

Locate well correctly on above
Section Plat

If a producing well is abandoned, date of last production 19
Was permission obtained from the Conservation Division or its agents before plugging was commenced? yes

Name of Conservation Agent who supervised plugging of this well Ralph Warren
Producing formation _____ Depth to top _____ Bottom _____ Total Depth of Well 3573 Feet
Show depth and thickness of all water, oil and gas formations.

OIL, GAS OR WATER RECORDS

CASING RECORD

FORMATION	CONTENT	FROM	TO	SIZE	PUT IN	PULLED OUT
		0	242'	8 5/8"	242'	none
		0	3572'	5 1/2"	3572'	3118'

Describe in detail the manner in which the well was plugged, indicating where the mud fluid was placed and the method or methods used in introducing it into the hole. If cement or other plugs were used, state the character of same and depth placed, from _____ feet to _____ feet for each plug set.

Filled hole with sand from 3573' to 3570' and dumped 5 sacks of cement.

Set plug at 250', set 10' rock bridge and dumped 5 sacks of cement.
Run 20 sacks of cement from 240' to 165'. Filled hole with mud to 40', set 10' rock bridge and capped well with 10 sacks of cement.

RECEIVED
STATE CORPORATION COMMISSION
JUL 3 1969
CONSERVATION DIVISION
Wichita, Kansas

(If additional description is necessary, use BACK of this sheet)
Name of Plugging Contractor PIPE PULLERS, INC.
Address Box 486, Ellinwood, Kansas

STATE OF Kansas COUNTY OF Barton, ss.
Evelyn Roth (employee of owner) or (owner or operator) of the above-described well, being first duly sworn on oath, says: That I have knowledge of the facts, statements, and matters herein contained and the log of the above-described well as filed and that the same are true and correct. So help me God.

(Signature) Evelyn Roth
Ellinwood, Kansas
(Address)

SUBSCRIBED AND SWORN to before me this 26th day of June, 19 69

My commission expires Feb. 10, 1971

George A. Meyer
Notary Public.

E. H. Adair Oil Company
Wichita 7, Kansas.

E. H. Adair Oil Company &
Lee Phillips Oil Company
Sittner No. 3.
45 ft. from South line
330 ft. from East line of
NW/4 of Sec. 35-21-12W,
Stafford County, Kansas.

Comm. 8-15-55
Comp. 8-30-55
Contractor: Ben Brack
Drilling Company
8-5/8 @ 242 ft.
5-1/2 @ 3572 w/75 ex.
Pro.

Figures indicate bottoms of Formations

Sand	to	135	Lime	to	3368
Redbeds		650	Shale		3372
Redbeds and shale		1260	Lime		3400
Shale		1475	Shale		3407
Lime & shale		2979	Lime		3450
Lime		3089	Shale		3453
Black shale		3093	Lime		3461
Lime & shale		3122	Shale		3464
Shale		3219	Lime		3472
Lime		3226	Shale		3482
Shale		3235	Lime		3486
Lime		3258	Shale		3489
Shale		3262	Lime		3498
Lime, cherty		3279	Conglomerate		3502
Shale		3282	Chert		3526
Lime		3296	Shale		3571
Shaly lime		3309	Dolomite		3573
Lime		3323			
Shale		3326			

Certified correct:

K. W. Johnson - Geologist.

RECEIVED
STATE CORPORATION COMMISSION
JUN 18 1969
CONSERVATION DIVISION
Wichita, Kansas