


STATE OF KANSAS  
STATE CORPORATION COMMISSION

WELL PLUGGING RECORD  
OR  
FORMATION PLUGGING RECORD

Strike out upper line when reporting plugging off formations.

Give All Information Completely  
Make Required Affidavit  
Mail or Deliver Report to:  
Conservation Division  
State Corporation Commission  
800 Biting Building  
Wichita, Kansas

NORTH

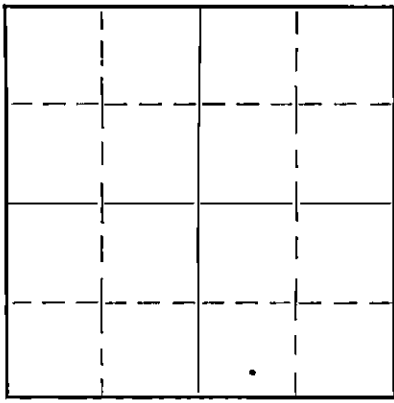

Locate well correctly on above Section Plat

Stafford County. Sec. 23 Twp. 21S Rge. 12W (E) (W)  
Location as "NE 1/4 NW 1/4 SW 1/4" or footage from lines C-E/2 SE/4 SE/4  
Lease Owner Fain Drilling Company  
Lease Name Katie Thul Well No. 1  
Office Address 2520 First Nat'l Bldg., Oklahoma City, Oklahoma  
Character of Well (Completed as Oil, Gas or Dry Hole) Dry hole  
Date, well completed February 12, 1941 193  
Application for plugging filed March 24, 1941 193  
Application for plugging approved 193  
Plugging Commenced March 24, 1941 193  
Plugging Completed March 28, 1941 193  
Reason for abandonment of well or producing formation Dry hole  
If a producing well is abandoned, date of last production no production 193  
Was permission obtained from the Conservation Division or its agents before plugging was commenced? Yes



Name of Conservation Agent who supervised plugging of this well C. T. Alexander  
Producing formation Siliceous Depth to top 3595 Bottom 3673 Total Depth of Well 3680 Feet.

Show depth and thickness of all water, oil and gas formations.

OIL, GAS OR WATER RECORDS			CASING RECORD			
Formation	Content	From	To	Size	Put In	Pulled Out
Siliceous Lime	Show of oil	3598	3606	10 3/4"	238'	None
" "	Dry	3606	3640	5 1/2	3593' 6"	1265.35'
" "	Dry	3650	3673			

Describe in detail the manner in which the well was plugged, indicating where the mud fluid was placed and the method or methods used in introducing it into the hole. If cement or other plugs were used, state the character of same and depth placed, from.....feet to.....feet for each plug set.

Filled with mud 3680 to 3665' ; Cement plug from 3665' to 3645' (3 sacks)  
Filled with mud from 3645' to 3593'; Cement plug (3 sacks) from 3593' to 3573';  
Filled with mud from 3573' to 238'; Cement Plug (9 sacks) from 238' to 218';  
Filled with mud from 218' to 14'; Cement Cap (5 sacks) from 14' to Cellar Base.

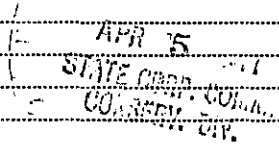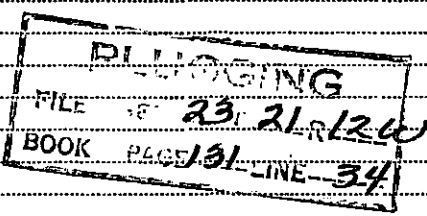

4-5-41

(If additional description is necessary, use BACK of this sheet)  
Correspondence regarding this well should be addressed to Fain Drilling Company  
Address 2520 First National Bldg., Oklahoma City, Oklahoma

STATE OF Oklahoma, COUNTY OF Oklahoma, ss.  
E. V. King

(Employee or owner) or (owner or operator) of the above-described well, being first duly sworn on oath, says: That I have knowledge of the facts, statements, and matters herein contained and the log of the above-described well as filed and that the same are true and correct. So help me God.

(Signature) E. V. King

Oklahoma City, Oklahoma (Address)

SUBSCRIBED AND SWORN TO before me this 4th day of April, 19 41

My commission expires October 3, 1944

Notary Public.

15.185.01068.0000

W E L L   R E C O R D

County: Stafford      Sec. 23      Twp., 21S      Rge. 12 W

Operator: Fain Drilling Company

Address: Oklahoma City, Oklahoma

Farm Name: Katie Thul      Well No. 1

Drilling Started: 1-9-41      Drilling Finished 2-12-41

Well Located: C-E/2 SE/4 SE/4 660' N of S line and 990' E of W Line of 1/4 Section

Elevation:    Derrick Floor \_\_\_\_\_      Ground \_\_\_\_\_

Character of Well: Dry Hole

OIL OR GAS SANDS OR ZONES

Siliceous Lime      3595-3640  
"      3650-3673

CASING RECORD

Size	Wt.	Lths	Make	Ft.	In.
10 3/4 "	36	8	Armco	238	0
5 1/2"	14	8	Smls.	3,593'	6"


CEMENTING RECORD

Size	Amount Set Ft.	Set In	Sacks Cement	Cementing Method
10 3/4"	238	0	200	Halliburton
5 1/2"	3593	6	100	"

TOOLS USED

Rotary top to 3606  
Cable 3606 - 3680

**PLUGGING**  
FILE SEC 23-21R120  
BOOK PAGE 131 LINE 34

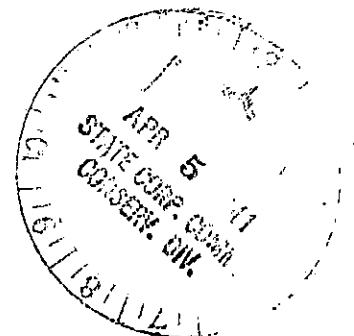

FORMATION RECORD

<u>Formation</u>	<u>From</u>	<u>To</u>		
Sand	0	40		
Sand and shale	40	220		
Red Bed	220	322		
Red Bed and shale	322	875		
Shale	875	1425		
Lime shells and shale	1425	1520		
Shale and Gyp shells	1520	1631		
Shale and Lime Shells	1631	1709		
Lime	1709	1735		
Broken Lime	1735	1763		
Shale and shells	1763	1855		
Lime	1855	1940		
Broken Lime and Shale	1940	2146		
Broken Lime	2146	2229		
Sticky Shale	2229	2255		
Shale and shells	2255	2372		
Lime	2372	2395		
Shale and Shells	2395	2410		
Shale	2410	2486		
Broken Lime and Shale	2486	2560		
Lime	2560	2589		
Broken Lime and Shale	2589	2717		
Lime	2717	2735		
Shale	2735	2750		
Lime	2750	2775		
Sandy shale	2775	2812		
Lime	2812	2820		
Shale and Lime Shells	2820	2845		
Lime	2845	2998		
Broken Lime	2998	3028		
Lime	3028	3145		
Lime and chert	3145	3165		
Shale	3165	3277		
Lime	3277	3525		
Lime and chert	3525	3532		
Lime	3525	3557		
Shale	3557	3595	3383-3399	5' 6"
Broken Lime	3595	3606	3598-3601	1' 6"
Lime	3606	3611	3601-3606	4' 6"
Lime Dolomite	3611	3615		
Lime	3615	3625		
Lime Dolomite	3625	3630		
Sandy white lime	3630	3635		
Lime	3635	3640		
Shale	3640	3650		
Broken Lime	3650	3655		
Lime	3655	3673		
Gray Lime	3673	3680		