


WELL PLUGGING RECORD

Give All Information Completely
Make Required Affidavit
Mail or Deliver Report to:
Conservation Division
State Corporation Commission
800 Bitting Building
Wichita, Kansas

NORTH

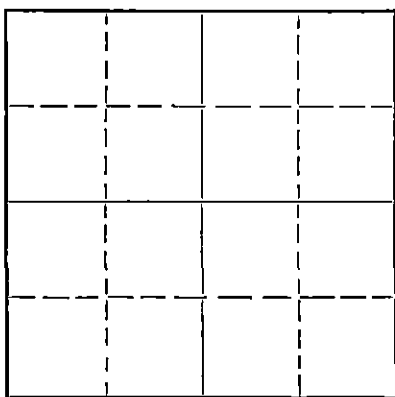

Locate well correctly on above Section Plat

Stafford County. Sec. 23 Twp. 21S Rge. 17E (W)
Location as "NE/CNW $\frac{1}{4}$ /SW $\frac{1}{4}$ " or footage from lines SW SW SE
Lease Owner Heathman & Co., Inc.
Lease Name Thul Well No. 1
Office Address 254 North Washington, Wichita, Kansas.
Character of Well (completed as Oil, Gas or Dry Hole) Dry Hole
Date well completed 2-17 1953
Application for plugging filed 2-17 1953
Application for plugging approved 2-17 1953
Plugging commenced 2-17 1953
Plugging completed 2-17 1953
Reason for abandonment of well or producing formation Dry Hole

If a producing well is abandoned, date of last production 19
Was permission obtained from the Conservation Division or its agents before plugging was commenced? Yes - By Telephone

Name of Conservation Agent who supervised plugging of this well Mr. H. A. Rives
Producing formation Depth to top Bottom Total Depth of Well 3700 Feet
Show depth and thickness of all water, oil and gas formations.

OIL, GAS OR WATER RECORDS

CASING RECORD

Formation	Content	From	To	Size	Put In	Pulled Out
				8 5/8"	252'	None

Describe in detail the manner in which the well was plugged, indicating where the mud fluid was placed and the method or methods used in introducing it into the hole. If cement or other plugs were used, state the character of same and depth placed, from feet to feet for each plug set.

Hole pumped full of Heavy Rotary Mud from 3700' to 240'.

Plug set at 240', cemented with 20 sacks.

Cement by Sun Oil Well Cementing Co., through Drill Pipe.

Hole pumped full of Heavy Rotary Mud from 240' to 35'.

Plug set at 35', cemented with 10 sacks.

Cement by Sun Oil Well Cementing Co.

RECEIVED
STATE CORPORATION COMMISSION
FEB 20 1953
CONSERVATION DIVISION
WICHITA, KANSAS

2-20-1953

(If additional description is necessary, use BACK of this sheet)

Correspondence regarding this well should be addressed to Heathman & Co., Inc.
Address 254 North Washington,
Wichita, Kansas

STATE OF Kansas, COUNTY OF Barton, ss.
C. E. Nance (employee of owner) or (owner or operator) of the above-described well,
being first duly sworn on oath, says: That I have knowledge of the facts, statements, and matters herein contained and the log of the above-described well as filed and that the same are true and correct. So help me God.

(Signature) C. E. Nance
Great Bend, Kansas (Address)

SUBSCRIBED AND SWORN TO before me this 26th day of February, 1953.

Zeneth A. Fisher
Notary Public.

My commission expires June 25, 1955.

PLUGGING
FRM 237-21R-147
BOOK PAGE 80 LINE 32

Comp Comm

HONAKER DRILLING COMPANY
2008 Lakin
Great Bend, Kansas

Thul #1
Operator: Heathman & Co., Inc.
Contractor: Honaker Drilling Co.
Comm: 2-3-53 Comp: 2-17-53
Total Depth 3700'

Sec. 23-21-12
Loc: SW SW SE
Stafford County, Kansas

Casing: 8-5/8" 251'

Production: D & A

0	220	Sand
220	249	Shale and Red Bed
249	540	Red Bed and shells
540	1125	Shale and shells
1125	1635	Lime and shale
1635	1745	Lime
1745	1900	Shale and lime
1900	2555	Lime and shale
2555	2655	Shale and lime
2655	2890	Lime and shale
2890	2930	Lime
2930	3058	Shale and lime
3058	3095	Lime
3095-	3255	Lime and shale
3255	3305	Lime
3305	3370	Lime and shel
3370	3383	Lime
3383	3430	Shale and lime
3430	3505	Sandy lime
3505	3644	Shale and lime
3644	3675	Conglomerate
3675	3700	Chert and lime
3700		Total Rotary Depth

Cemented 8-5/8" casing at 251'
w/ 225 sacks cement and 3sacks
Calcium Chloride.

I certify that this is the true and correct copy of the above log, to the best of my knowledge.

J. G. Honaker

Subscribed and sworn to before me this 20th day of February 1953.

Kenneth O. Fisher
Notary Public

My commission expires: 6-25-55

RECEIVED
STATE DEPARTMENT OF COMMISSION
FEB 22 1953
STATE DEPARTMENT OF COMMISSION

PLUGGING
FILE SEC 23 T 21 R 244
BOOK PAGE 80 LINE 24