


WELL PLUGGING RECORD

Give All Information Completely  
Make Required Affidavit  
Mail or Deliver Report to:  
Conservation Division  
State Corporation Commission  
212 North Market, Insurance Bldg.  
Wichita, Kansas

STAFFORD County. Sec. 23 Twp. 21S Rge. 12W (E) (W)  
Location as "NE/CNW/SW" or footage from lines SW NE NW  
Lease Owner WESTERN PETROLEUM CO., INC.  
Lease Name THUL Well No. 1  
Office Address 925 PATTON ROAD, GREAT BEND, KANSAS  
Character of Well (completed as Oil, Gas or Dry Hole) DRY HOLE  
Date well completed 6-26 19 61  
Application for plugging filed 6-27 19 61  
Application for plugging approved 6-28 19 61  
Plugging commenced 6-29 19 61  
Plugging completed 7-3 19 61  
Reason for abandonment of well or producing formation DID NOT PRODUCE  
DRY HOLE  
If a producing well is abandoned; date of last production DID NOT PRODUCE 19  
Was permission obtained from the Conservation Division or its agents before plugging was commenced? YES

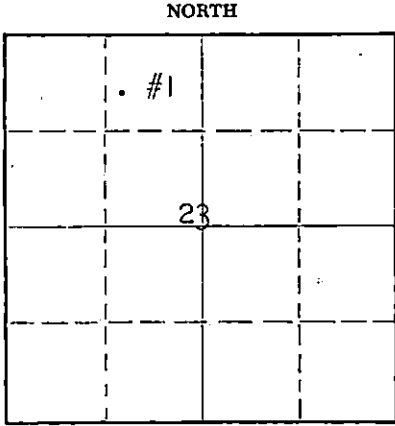

Locate well correctly on above Section Plat

Name of Conservation Agent who supervised plugging of this well FRANK BROADFOOT  
Producing formation ----- Depth to top ----- Bottom ----- Total Depth of Well 3708 Feet  
Show depth and thickness of all water, oil and gas formations.

OIL, GAS OR WATER RECORDS

CASING RECORD

FORMATION	CONTENT	FROM	TO	SIZE	PUT IN	PULLED OUT
SURFACE WTR.	WATER		150	8-5/8	264	-----
ARBUCKLE	WATER	3574	3708	4 1/2	3700	3100'

Describe in detail the manner in which the well was plugged, indicating where the mud fluid was placed and the method or methods used in introducing it into the hole. If cement or other plugs were used, state the character of same and depth placed, from ----- feet to ----- feet for each plug set.

FILLED HOLE WITH MUD TO 3660', GRAVEL FROM 3660' TO 3552', CEMENTED WITH 5 SACKS CEMENT  
MUDDED UP TO 240', MADE SOLID ROCK BRIDGE, CEMENTED WITH 20 SACKS CEMENT. MUDDED UP TO  
40' MADE SOLID ROCK BRIDGE, RAN 10 SACKS CEMENT TO BASE OF CELLAR.

RECEIVED  
STATE CORPORATION COMMISSION

JUL 7 1961

CONSERVATION DIVISION  
Wichita, Kansas

(If additional description is necessary, use BACK of this sheet)

Name of Plugging Contractor MORGAN WELL PLUGGING SERVICE  
Address CHASE, KANSAS

STATE OF KANSAS, COUNTY OF BARTON, ss.  
JOHN H. VOLOSIN (employee of owner) or (owner or operator) of the above-described well, being first duly sworn on oath, says: That I have knowledge of the facts, statements, and matters herein contained and the log of the above-described well as filed and that the same are true and correct. So help me God.

(Signature) John H. Volosin  
JOHN H. VOLOSIN, GENERAL MANAGER  
925 PATTON ROAD, GREAT BEND, KANSAS  
(Address)

SUBSCRIBED AND SWORN TO before me this 6TH day of JULY, 1961

Reva C. Brown  
REVA C. BROWN Notary Public.

My commission expires JANUARY 15, 1963



15.185.12376.0000

DRILLER'S LOG

COMPANY: WESTERN PETROLEUM Co., INC. LOCATION: SW NE NW, SEC. 23-21S-12W.  
 STAFFORD COUNTY, KANSAS  
 CONTRACTOR: WESTERN PETROLEUM Co., INC. ELEVATION: 1854 K.B.  
 FARM NAME: THUL CASING USED: 8-5/8" @ 264' w/225 sx  
 Pozmix & 13 sx HA5 MIXED  
 COMMENCED: MAY 22, 1961 4-1/2" @ 3700' w/60 sx  
 COMPLETED: JUNE 8, 1961 Pozmix, 2% JELL

SURFACE CLAY & SAND	70
SHALE	180
SAND	240
RED BED	261
RED BED & SHALE	630
ANHYDRITE	660
SHALE, SHELLS & SALT	1075
SHALE & SHELLS	1587
SHALE & LIME	1780
LIME & SHALE	2204
SHALE & LIME	2892
LIME	3000
LIME & SHALE	3210
LIME	3480
LIME & SHALE	3552
LIME	3573
ARBUCKLE	3708
ROTARY TOTAL DEPTH	3708

**RECEIVED**  
STATE CORPORATION COMMISSION

JUN 28 1961

CONSERVATION DIVISION  
Wichita, Kansas

STATE OF KANSAS )  
 ) SS.  
 COUNTY OF BARTON )

I, THE UNDERSIGNED, BEING DULY SWORN ON OATH, STATE THAT THE ABOVE STATEMENT AND LOG ARE TRUE AND A CORRECT RECORD AND LOG OF THE WELL DRILLED AT THE LOCATION ABOVE DESCRIBED.

WESTERN PETROLEUM CO., INC.

*John H. Volosin*  
 JOHN H. VOLOSIN  
 GENERAL MANAGER

SUBSCRIBED AND SWORN TO BEFORE ME THIS 12TH DAY OF JUNE, 1961.

*Reva C. Brown*  
 REVA C. BROWN, NOTARY PUBLIC.

MY COMMISSION EXPIRES JANUARY 15, 1963.