


WELL PLUGGING RECORD

Give All Information Completely  
Make Required Affidavit  
Mail or Deliver Report to:  
Conservation Division  
State Corporation Commission  
800 Blitting Building  
Wichita, Kansas

NORTH

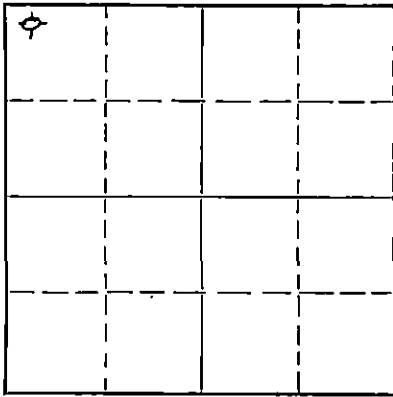

Locate well correctly on above Section Plat

Stafford County, Sec. 23 Twp. 21 Rge. 12 (E) (W)  
Location as "NE/CNW $\frac{1}{4}$ SW $\frac{1}{4}$ " or footage from lines NW NW NW  
Lease Owner Virginia Drilling Co., Inc. et al  
Lease Name Maxwell Well No. 1-Reworked  
Office Address 701 Brown Bldg., Wichita, Kansas  
Character of Well (completed as Oil, Gas or Dry Hole) Dry Hole  
Date well completed October 26 1950  
Application for plugging filed November 10 1950  
Application for plugging approved November 10 1950  
Plugging commenced November 10 1950  
Plugging completed November 10 1950  
Reason for abandonment of well or producing formation  
If a producing well is abandoned, date of last production 19  
Was permission obtained from the Conservation Division or its agents before plugging was commenced? yes

Name of Conservation Agent who supervised plugging of this well G. D. Stough  
Producing formation Depth to top Bottom Total Depth of Well 3431 Feet  
Show depth and thickness of all water, oil and gas formations.


OIL, GAS OR WATER RECORDS

CASING RECORD

Formation	Content	From	To	Size	Put In	Pulled Out
				5 1/2"	1704	1502 2"

Describe in detail the manner in which the well was plugged, indicating where the mud fluid was placed and the method or methods used in introducing it into the hole. If cement or other plugs were used, state the character of same and depth placed, from feet to feet for each plug set.

Mudded 1667 - 312  
Rock bridge 312 - 300  
15 sacks cement 300-260  
Mud 260-25  
10 sacks cement 25-0

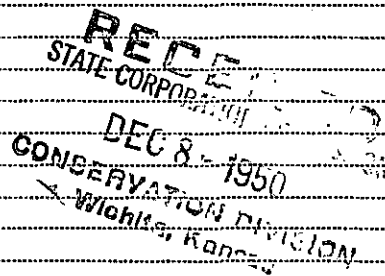

(If additional description is necessary, use BACK of this sheet)

Correspondence regarding this well should be addressed to Virginia Drilling Co., Inc.  
Address 701 Brown Bldg., Wichita 2, Kansas

STATE OF Kansas, COUNTY OF Sedgwick, ss.  
S. A. Murphy (employee of owner) or (owner or operator) of the above-described well,  
being first duly sworn on oath, says: That I have knowledge of the facts, statements, and matters herein contained and the log of the above-described well as filed and that the same are true and correct. So help me God.

(Signature) *S. A. Murphy*  
701 Brown Bldg., Wichita 2, Kansas  
(Address)

SUBSCRIBED AND SWORN to before me this 7th day of December, 1950.  
*Ivey M. Newman*  
Notary Public.

My commission expires March 15, 1954 28-8278-s 4-50-10M

