


STATE OF KANSAS  
STATE CORPORATION COMMISSION

Form CP-4

WELL PLUGGING RECORD

Give All Information Completely  
Make Required Affidavit  
Mail or Deliver Report to:  
Conservation Division  
State Corporation Commission  
212 No. Market  
Wichita, Kansas 67202

NORTH

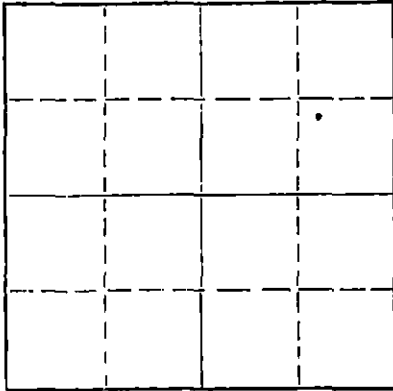

Locate well correctly on above  
Section Plat

Stafford County. Sec. 14 Twp. 21 Rge. (E) 13 (W)  
Location as "NE/CNW/SE" or footage from lines NW SE NE  
Lease Owner White Hawk Oil Company  
Lease Name Doran Well No. 3  
Office Address P.O. Box 1150, Great Bend, Kansas 67530  
Character of Well (completed as Oil, Gas or Dry Hole) oil  
Date well completed 19  
Application for plugging filed October 3 19 69  
Application for plugging approved 19  
Plugging commenced October 30 19 69  
Plugging completed November 8 19 69  
Reason for abandonment of well or producing formation depleted

If a producing well is abandoned, date of last production 19  
Was permission obtained from the Conservation Division or its agents before plugging was commenced? yes

Name of Conservation Agent who supervised plugging of this well Ralph Warren  
Producing formation Depth to top Bottom Total Depth of Well 3590 Feet  
Show depth and thickness of all water, oil and gas formations.

OIL, GAS OR WATER RECORDS

CASING RECORD

FORMATION	CONTENT	FROM	TO	SIZE	PUT IN	PULLED OUT
		0	238'	8 5/8"	238'	none
		0	3589'	5 1/2"	3589'	1402.30

Describe in detail the manner in which the well was plugged, indicating where the mud fluid was placed and the method or methods used in introducing it into the hole. If cement or other plugs were used, state the character of same and depth placed, from feet to feet for each plug set.

Sanded back to 2800' and dumped 5 sacks of cement.

Squeezed well with 15 sacks gel mud and 75 sacks of cement.

RECEIVED  
STATE CORPORATION COMMISSION  
NOV 13 1969  
CONSERVATION DIVISION  
Wichita, Kansas

(If additional description is necessary, use BACK of this sheet)  
Name of Plugging Contractor PIPE PULLERS, INC.  
Address Box 486, Ellinwood, Kansas

STATE OF Kansas, COUNTY OF Barton, ss.  
Evelyn Roth (employee of owner) or (owner or operator) of the above-described well, being first duly sworn on oath, says: That I have knowledge of the facts, statements, and matters herein contained and the log of the above-described well as filed and that the same are true and correct. So help me God.

(Signature) Evelyn Roth  
Ellinwood, Kansas (Address)

SUBSCRIBED AND SWORN TO before me this 12th day of November, 19 69

My commission expires Feb. 10, 1971

Serge A Meyer  
Notary Public.

DRILLER'S LOG

COMPANY: Westgate-Greenland Oil Co, et al  
 CONTRACTOR: Westgate Drilling Corporation  
 FARM: Doran #3  
 LOCATION: NW SE NE Sec. 14-21-13W  
 Stafford County, Kansas  
 COMMENCED: July 26, 1952 - Rotary  
 August 11, 1952- Cardwell  
 COMPLETED: August 7, 1952 - Rotary  
 August 12, 1952 - Cardwell  
 ELEVATION: 1864 DF

0	to	30	Clay and sand
30	to	145	Sand
145	to	226	Shale-shells-sand
226	to	240	Shale-shells
240	to	712	Red bed W/sand streaks
712	to	740	Anhydrite
740	to	1225	Shale and shells
1225	to	1500	Shale - salt - shells
1500	to	2925	Shale and lime
2925	to	3025	Lime
3025	to	3126	Lime and shale
3126	to	3127	Lime
3127	to	3131	Heebner shale
3131	to	3162	Lime W/shale breaks
3162	to	3186	Shale W/sand streaks
3186	to	3255	Shale and sandy shale
3255	to	3483	Lime
3483	to	3529	Shale and lime
3529	to	3590	Arbuckle lime
		3590	T. D. (RB)

RECEIVED  
 STATE CORPORATION COMMISSION  
 OCT 6 1969  
 CONSERVATION DIVISION  
 Wichita, Kansas

Set 238' of 8 5/8" OD 24# surface. Cemented with 200 sacks cement and 2 sacks calcium chloride.

Set 3589 feet of 5 1/2" 40# used casing. Cemented with 100 sacks cement.

Drill Stem Tests:

- #1- 3293-3313, open 1 hr, rec. 1250' gassy oil, gas to surface in 10 minutes, 30 feet oil cut mud, 1050# BHP.
- #2- 3321-3356, open 1 hour, gas in 16 minutes, 250' froggy gassy oil, 355' gassy oil, 1150# BHP.
- #3- 3382-3423, open 1 hour, gas in 7 minutes, 3335' ~~fluid~~ fluid, 3125' gassy oil, 200' oil cut mud, 1260# BHP.
- #4- 3527-43, open 1 hour, rec. 1405' gassy oil, 360' froggy oil, 2975' gas, 620# BHP.
- #5- 3547-63, open 1 hour, 2793' gassy oil, 90' froggy oil, 1100# BHP.

TOPS:	Geologists	Schlumberger	Geologists	Schlum
Anhydrite	710		Lansing	3267
Heebner	3125	3120	Arbuckle	3527
Brown Lime	3252	3250		3263
				3516

Perforated 95 shots 3528-60, filled up 2300' oil in 1 1/2 hours. Swabbed 47 BO in 1 hour 1500' off bottom. Swabbed 351 BO in 14 hours, no water, no acid.

8/12/52 Filed 25 BOPD temporary productivity affidavit.  
 POTENTIAL: 476 Barrels

NOV 10 1952 REC'D

C E R T I F I C A T E

I, Don Allen, do hereby certify that the above and fore-  
going is a true and correct copy of log of the Doran #3,  
NW SE NE Section 14-21-13W, Stafford County, Kansas, as  
reflected by files of the Westgate-Greenland Oil Company.

Don Allen  
Don Allen

Subscribed and sworn to before me, a Notary Public, within  
and for Sedgwick County, Kansas, this 12th day of August,  
1952.

Esther Unsell  
Esther Unsell, Notary Public

My commission expires May 25, 1953.

RECEIVED  
STATE CORPORATION COMMISSION  
OCT 6 1969  
CONSERVATION DIVISION  
Wichita, Kansas