


WELL PLUGGING RECORD

Give All Information Completely  
Make Required Affidavit  
Mail or Deliver Report to:  
Conservation Division  
State Corporation Commission  
800 Bittling Building  
Wichita, Kansas

Stafford County, Sec. 14 Twp. 21S Rge. 13 (E) W (W)  
Location as "NE/CNW¼SW¼" or footage from lines \_\_\_\_\_  
Lease Owner Brooks Pierce Drilling Co.  
Lease Name Rothgarn Well No. 1  
Office Address 1208 Union National Bank Bldg. Wichita, Kansas  
Character of Well (completed as Oil, Gas or Dry Hole) Dry Hole  
Date well completed April 5, 1953 19 53  
Application for plugging filed April 5, 19 53  
Application for plugging approved April 5, 19 53  
Plugging commenced April 5, 19 53  
Plugging completed April 6, 19 53  
Reason for abandonment of well or producing formation Dry Hole

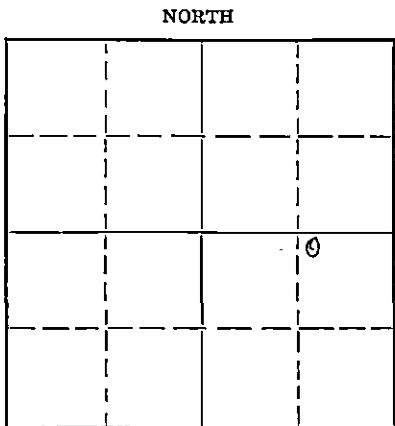

Locate well correctly on above Section Plat

If a producing well is abandoned, date of last production \_\_\_\_\_ 19 \_\_\_\_  
Was permission obtained from the Conservation Division or its agents before plugging was commenced? Yes

Name of Conservation Agent who supervised plugging of this well Charles Stough, Great Bend, Kansas  
Producing formation \_\_\_\_\_ Depth to top \_\_\_\_\_ Bottom \_\_\_\_\_ Total Depth of Well 3669 Feet  
Show depth and thickness of all water, oil and gas formations.

OIL, GAS OR WATER RECORDS

CASING RECORD

Formation	Content	From	To	Size	Put In	Pulled Out
				8 5/8"	250'	0

Describe in detail the manner in which the well was plugged, indicating where the mud fluid was placed and the method or methods used in introducing it into the hole. If cement or other plugs were used, state the character of same and depth placed, from \_\_\_\_\_ feet to \_\_\_\_\_ feet for each plug set.  
Filled Hole w/ Heavy Mud 3669' to 240'  
Howco Separation Plug 240' to 238'  
20 Sacks Cement 238'  
Heavy Mud 238' to 20'  
10 Sacks Cement 20' to Surface

STATE CORPORATION COMMISSION  
APR 15 1953  
CONSERVATION DIVISION  
Wichita, Kansas  
4-14-1953

(If additional description is necessary, use BACK of this sheet)  
Name of Plugging Contractor Bud Edwards Drilling Company  
Address 510 Petroleum Building, Wichita, Kansas

STATE OF Kansas COUNTY OF Sedgwick, ss.  
Bud Edwards (employee of owner) or (owner or operator) of the above-described well, being first duly sworn on oath, says: That I have knowledge of the facts, statements, and matters herein contained and the log of the above-described well as filed and that the same are true and correct. So help me God.

(Signature) Bud Edwards  
510 Petroleum Bldg. Wichita, Kansas  
(Address)

SUBSCRIBED AND SWORN TO before me this 6 day of April, 1953  
Louise Burnett  
Notary Public.

My commission expires March 14, 1956

**PLUGGING**  
FILE SEC 14 T 21 R 13W  
BOOK PAGE 91 LINE 21

*Bud Edwards*  *Drilling Co.*

DRILLING CO.

April 5, 1953


Brooks Pierce Drilling Co.  
1208 Union Nat'l. Bldg.  
Wichita, Kansas

Commenced Drilling  
3/23/53  
Completed Drilling  
4/5/53

Driller's Log on Rothgarn Lease, Sec. 14-21S-13 W., Stafford  
County, Kansas

0'	140'	Sand
140'	168'	Lime
168'	215'	Sand
215'	265'	Lime
265'	700'	Red Rock
700'	1180'	Red Rock & Shale
1180'	1580'	Shale w/Lime Streaks
1580'	1670'	Lime
1670'	1825'	Lime w/ Cherty Streaks
1825'	1925'	Lime w/ Shale Streaks
1925'	1995'	Sandy Lime
1995'	2115'	Lime w/ Shale Streaks
2115'	2220'	Lime
2220'	2400'	Lime w/ Shale Streaks
2400'	2690'	Lime & Shale Broken
2690'	2775'	Shale
2775'	2955'	Lime & Shale - Broken
2955'	3035'	Lime
3035'	3070'	Shale
3070'	3235'	Lime
3235'	3295'	Lime w/ Shale Streaks
3295'	3560'	Lime
3560'	3569'	Congolomerate
3569'	3669'	Lime
	3669'	T.D.

BUD EDWARDS DRILLING CO.

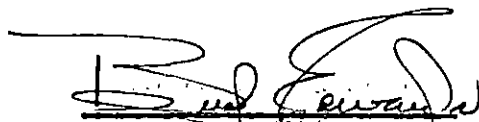

RECEIVED  
STATE CORPORATION COMMISSION

APR 14 1953

CONSERVATION DIVISION  
Wichita, Kansas

FILED  
DIVISION

**PLUGGING**  
FILE SEC 14 T 21 R 13W  
BOOK PAGE 91 LINE 2