

WELL PLUGGING RECORD


STATE OF KANSAS STATE CORPORATION COMMISSION

Give All Information Completely Make Required Affidavit Mail or Deliver Report to: Conservation Division State Corporation Commission 800 Bitting Building Wichita, Kansas

FORMATION PLUGGING RECORD

Strike out upper line when reporting plugging off formations.

Stafford County. Sec. 14 Twp. 21S Rge. 13 (W) Location as "NE 1/4 NW 1/4 SW 1/4" or footage from lines NE NE SE Lease Owner Petroleum, Inc. Lease Name Rothgarn Well No. 2 Office Address 100 Derby Building, Wichita 2, Kansas Character of Well (completed as Oil, Gas or Dry Hole) Dry Hole Date well completed May 9, 19.50 Application for plugging filed May 15, 19.50 Application for plugging approved May 11, 19.50 Plugging commenced May 9, 19.50 Plugging completed May 9, 19.50 Reason for abandonment of well or producing formation Dry Hole

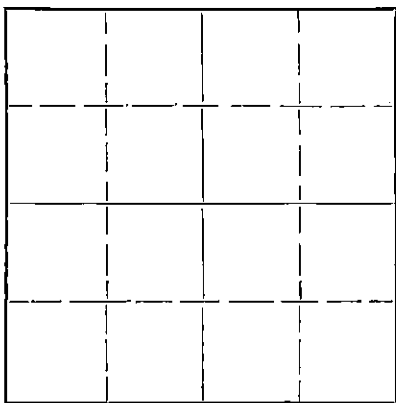

Locate well correctly on above Section Plat

If a producing well is abandoned, date of last production 19. Was permission obtained from the Conservation Division or its agents before plugging was commenced? Yes

Name of Conservation Agent who supervised plugging of this well C. D. Stough, Box 207, Great Bend, Ks. Producing formation Depth to top Bottom Total Depth of Well 3636 Feet Show depth and thickness of all water, oil and gas formations.

OIL, GAS OR WATER RECORDS

CASING RECORD

Table with 7 columns: Formation, Content, From, To, Size, Put In, Pulled Out. Row 1: 8 5/8", 193'

Describe in detail the manner in which the well was plugged, indicating where the mud fluid was placed and the method or methods used in introducing it into the hole. If cement or other plugs were used, state the character of same and depth placed, from feet to feet for each plug set.

Filled hole with mud to 190', placed plug at 190'. Mixed and displaced through drill pipe 15 sacks of cement, filled hole with mud to 30', placed plug at 30', mixed and dumped 10 sacks of cement, filled hole to bottom of cellar.

5-16-1950 MAY 16 1950

(If additional description is necessary, use BACK of this sheet)

Correspondence regarding this well should be addressed to PETROLEUM, INC. Address 100 Derby Building Wichita 2, Kansas


STATE OF KANSAS, COUNTY OF SEDGWICK, ss. Eric H. Jager (employee of owner) of the above-described well, being first duly sworn on oath, says: That I have knowledge of the facts, statements, and matters herein contained and the log of the above-described well as filed and that the same are true and correct. So help me God.

(Signature) Eric H. Jager Executive Vice-President 100 Derby Bldg, Wichita 2, Kansas (Address)

SUBSCRIBED AND SWORN to before me this 15th day of May, 19 50

Notary Public signature: Marjorie Bradshaw

My commission expires October 27, 1952.

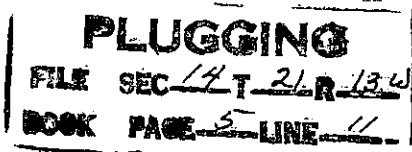

WELL LOG ROTHGARN NO. 2

Petroleum, Inc., Lease Owner

2 Section 14, Twp. 21S, Rge. 13W

Garvey Oil, Contractor

Location: NE NE SE

Rotary Total Depth: 3636'

County, Stafford, Kansas

Commenced: April 27, 1950

Production:

Completed: May 9, 1950

Elevation: 1869 D.F.

Casing: 193' of 8 5/8"

Figures below indicate bottom of formation:

180	Sand		
193	Shale & Shells		
230	Sand		
300	Shale & Shells		
460	Red Bed	712	Anhydrite
735	Anhydrite	3142	Heebner
870	Shale & Red Bed	3163	Toronto
1190	Shale & Shells	3177	B.O.
1585	Lime & Shale	3269	Br. Lime
1655	Lime	3285	Lansing
1765	Lime & Shale	3504	B.K.C.
1935	Lime	3520	P.B.C.
2075	Lime & Shale		
2330	Shale & Shells	3636	R.T.D.
2675	Shale		
2785	Shale & Shells		
2985	Lime		
3070	Shale		
3130	Lime		
3262	Lime & Shale		
3330	Lime		
3583	Conglomerate		
3620	Shale		

I hereby certify that this is a true and correct log of the above mentioned well.

PETROLEUM, INC.

*Eric H. Jager*  
Eric H. Jager

STATE OF KANSAS  
SS.  
SEDGWICK COUNTY

**PLUGGING**  
FILE SEC 14 T 21 R 13W  
BOOK PAGE 5 LINE 11

Subscribed to and sworn to before me, a Notary Public in said County and State this 15th day of May, 1950.

*Margorie Bradshaw*  
Notary Public

My Commission Expires: October 27, 1952.