


STATE OF KANSAS
STATE CORPORATION COMMISSION

WELL PLUGGING RECORD

Give All Information Completely
Make Required Affidavit
Mail or Deliver Report to:
Conservation Division
State Corporation Commission
800 Bitting Building
Wichita, Kansas

Stafford County, Sec. 14 Twp. 21 Rge. (E) 13 (W)
Location as "NE/CNW%SW%" or footage from lines NE $\frac{1}{4}$ NW $\frac{1}{4}$ SE $\frac{1}{4}$
Lease Owner Courtney B. Davis, Inc.
Lease Name Rothgarn Well No. 1
Office Address 402 Union National Bank Bldg., Wichita, Kansas
Character of Well (completed as Oil, Gas or Dry Hole) Dry Hole
Date well completed 9-13 1953
Application for plugging filed 9-13 1953
Application for plugging approved 9-13 1953
Plugging commenced 9-13 1953
Plugging completed 9-13 1953
Reason for abandonment of well or producing formation _____

NORTH

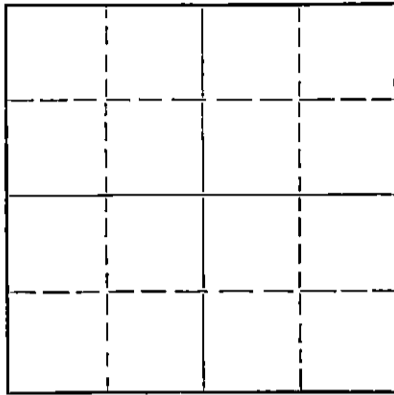

Locate well correctly on above
Section Plat

If a producing well is abandoned, date of last production _____ 19____
Was permission obtained from the Conservation Division or its agents before plugging was commenced? Yes

Name of Conservation Agent who supervised plugging of this well Mr. M. A. Rives
Producing formation _____ Depth to top _____ Bottom _____ Total Depth of Well 3650 Feet
Show depth and thickness of all water, oil and gas formations.

OIL, GAS OR WATER RECORDS

CASING RECORD

FORMATION	CONTENT	FROM	TO	SIZE	PUT IN	PULLED OUT
				8-5/8"	247'	None

Describe in detail the manner in which the well was plugged, indicating where the mud fluid was placed and the method or methods used in introducing it into the hole. If cement or other plugs were used, state the character of same and depth placed, from _____ feet to _____ feet for each plug set.

Set plug @ 240' with 20 Sx Cement. Top
Plug @ 35' with 10 Sx Cement

(If additional description is necessary, use BACK of this sheet)

Name of Plugging Contractor Lewis Drilling Company
Address 607 Union National Bank Bldg., Wichita, Kansas

STATE OF KANSAS, COUNTY OF SEDGWICK, ss.
L. L. Bailey (employee of owner) or (owner or operator) of the above-described

well, being first duly sworn on oath, says: That I have knowledge of the facts, statements, and matters herein contained and the log of the above-described well as filed and that the same are true and correct. So help me God.

(Signature) L. L. Bailey

607 Union National Bank Bldg., Wichita, Kansas
(Address)

SUBSCRIBED AND SWORN to before me this 15th day of September 19 53

My commission expires August 20, 1956

Arthur P. Harrington
Notary Public.

RECORDED
STATE CORPORATION COMMISSION
SEP 23 1953
24-786p16 3-53-20M

PLUGGING
FILE SEC 14 T 21 R 13
BOOK PAGE 128 LINE 44

WELL LOG

COMPANY Courtney B. Davis, Inc.

SEC. 14 T. 21 R. 13W

FARM Rothgarn

NO. 1

LOG.

NE 1/4 NW 1/4 SE 1/4

TOTAL DEPTH 3650'

COMM. 9-5-53


COMP. 9-13-53

COUNTY Stafford
KANSAS

SHOT OR TREATED

CONTRACTOR Lewis Drilling Company

ISSUED

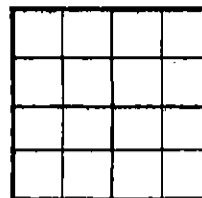

CASING

20	10
15	XX 8-5/8" 247'
12	6
13	5

ELEVATION

PRODUCTION

FIGURES INDICATE BOTTOM OF FORMATIONS

0	=	195	Sand
195	=	215	Hard Sand
215	=	247	Shale
247	=	715	Red Bed
715	=	745	Anhydrite
745	=	1775	Shale & Shells
1775	=	2945	Shale & Lime
2945	=	3105	Lime
3105	=	3148	Lime & Shale Strs
3148	=	3400	Lime & Shale
3400	=	3530	Lime
3530	=	3540	Shale
3540	=	3650	Lime
3650	=	TD	

RECEIVED
STATE CORPORATION COMMISSION
SEP 27 1953
CONSOLIDATED DIVISION
WICHITA, KANSAS

PLUGGING
FILE SEC 14 T 21 R 13W
BOOK PAGE 128 LINE 44

State of KANSAS)
County of SEDGWICK) SS:

I, L. L. Bailey of the Lewis Drilling Company

upon oath state that the above and foregoing is a true and correct copy of the log of the Rothgarn #1 well.

L. L. Bailey

Subscribed and sworn to before me this 15th day of September 19 53

My Commission Expires: August 20, 1956

Arthur P. Herrington
NOTARY PUBLIC