


STATE OF KANSAS  
STATE CORPORATION COMMISSION  
CONSERVATION DIVISION  
P. O. BOX 17027  
WICHITA, KANSAS 67217

FORM CP-4

WELL PLUGGING RECORD

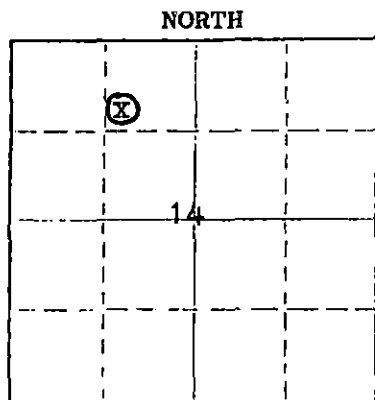

Locate well correctly on above Section Plat

Stafford County, Sec. 14 Twp. 21 S Rge. 13 (W)  
Location as "NE/CNW/SE/SW" or footage from lines SW NE NW

Lease Owner L. D. Davis  
Lease Name Krey Well No. CH-2  
Office Address P. O. Box 324 Great Bend, Kansas 67530  
Character of Well (completed as Oil, Gas or Dry Hole) Abandoned Anhy. core hole  
Date well completed August 9 19 75  
Application for plugging filed 8-8-75 by phone; 9-23-75 in 19 75  
Application for plugging approved August 8 writing 19 75  
Plugging commenced August 9 19 75  
Plugging completed August 9 19 75  
Reason for abandonment of well or producing formation Anhydrite was too low.

If a producing well is abandoned, date of last production \_\_\_\_\_ 19 \_\_\_\_  
Was permission obtained from the Conservation Division or its agents before plugging was commenced? Yes-by phone from State Pluggers

Name of Conservation Agent who supervised plugging of this well Mr. G.R. Biberstein  
Producing formation None Depth to top \_\_\_\_\_ Bottom \_\_\_\_\_ Total Depth of Well 760 Feet  
Show depth and thickness of all water, oil and gas formations.

OIL, GAS OR WATER RECORDS

CASING RECORD

FORMATION	CONTENT	FROM	TO	SIZE	PUT IN	PULLED OUT
None						

Describe in detail the manner in which the well was plugged, indicating where the mud fluid was placed and the method or methods used in introducing it into the hole. If cement or other plugs were used, state the character of same and depth placed, from \_\_\_\_\_ feet to \_\_\_\_\_ feet for each plug set.

5 sacks of cement was pumped in at 760 feet  
10 sacks of cement was pumped in at 500 feet  
5 sacks of cement was pumped in at 40 feet to the surface.

SEP 25 1975

Name of Plugging Contractor Exploration, Inc. Permit # 048  
Address 610 Petroleum Bldg. Wichita, Kansas 67202

STATE OF Kansas COUNTY OF Sedgwick  
Bill Ham Representative of \_\_\_\_\_

well, being first duly sworn on oath, says: That I have knowledge of the facts, statements, and matters herein contained and the log of the above-described well as filed and that the same are true and correct. So help me God.

(Signature) Bill Ham  
610 Petroleum Bldg.-Wichita, Kansas  
(Address) 67202

SUBSCRIBED AND SWORN TO before me this 23rd day of September, 19 75

My commission expires \_\_\_\_\_  
**KAREN A. WHITE**  
STATE WIDE  
NOTARY PUBLIC  
Sedgwick County, Kansas  
My Comm. Exp. Nov. 23, 1975

Karen A. White  
Notary Public.

L.D. DAVIS

DESIGNATE TYPE OF COMP.: OIL, GAS,  
 DRY HOLE, SWDOW, ETC.:  
 Dry-T.D. at Anhydrite

Well No.  
 CH-2

Loco Name  
 KREY

S 14 T 21 R 13 W

SW NE NW

WELL LOG

Show all important zones of porosity and contents thereof; cored intervals, and all drill-stem tests, including depth interval tested, cushion used, time tool open, flowing and shut-in pressures, and recoveries.

SHOW GEOLOGICAL MARKERS, LOGS RUN, OR OTHER DESCRIPTIVE INFORMATION.

FORMATION DESCRIPTION, CONTENTS, ETC.	TOP	BOTTOM	NAME	DEPTH
Sand and shale	0	75		
Pyrite	75	83		
Shale	83	208		
Dakota Sand	208	243		
Shale	243	713		
Anhydrite	713	729	Stone Corral	
Shale	729	760	Anhydrite	

RECEIVED  
 STATE CORPORATION COMMISSION  
 SEP 25 1975  
 CONSERVATION DIVISION  
 Wichita, Kan.

USE ADDITIONAL SHEETS, IF NECESSARY, TO COMPLETE WELL RECORD.

Date Received

Signature  
 Title  
 Date