


STATE OF KANSAS  
STATE CORPORATION COMMISSION

WELL PLUGGING RECORD

Give All Information Completely  
Make Required Affidavit  
Mail or Deliver Report to  
Conservation Division  
State Corporation Comm.  
245 North Water  
Wichita, KS 67202

Stafford County, Sec. 14 Twp. 21 Rge. 13 E/W  
Location as "NE/CNW $\frac{1}{4}$ SW $\frac{1}{4}$ " or footage from lines  
SW NE NW

Lease Owner L. D. Davis  
Lease Name Krey Well No. 2  
Office Address Box 324, Great Bend, Kansas 67530  
Character of Well (Completed as Oil, Gas or Dry Hole)

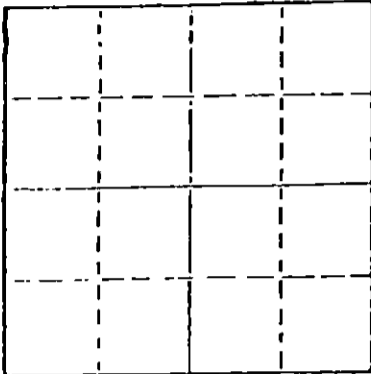

Dry Hole  
Date Well completed June 22 1976  
Application for plugging filed June 22 1976  
Application for plugging approved June 22 1976  
Plugging commenced June 22 1976  
Plugging completed June 22 1976  
Reason for abandonment of well or producing formation

Dry Hole  
If a producing well is abandoned, date of last production 19

Was permission obtained from the Conservation Division or its agents before plugging was commenced? yes

Name of Conservation Agent who supervised plugging of this well G. R. Biberstein  
Producing formation \_\_\_\_\_ Depth to top \_\_\_\_\_ Bottom \_\_\_\_\_ Total Depth of Well 3575'  
Show depth and thickness of all water, oil and gas formations.

OIL, GAS OR WATER RECORDS

CASING RECORD

FORMATION	CONTENT	FROM	TO	SIZE	PUT IN	PULLED OUT

Describe in detail the manner in which the well was plugged, indicating where the mud fluid was placed and the method or methods used in introducing it into the hold. If cement or other plugs were used, state the character of same and depth placed, from \_\_\_\_\_ feet to \_\_\_\_\_ feet for each plug set.

Bottom plug @ 250' w/35 sacks cement.

Top plug @ 40' w/15 sacks cement.

5 sacks cement in rat hole.

Plugged water well.

(If additional description is necessary, use BACK of this sheet)

Name of Plugging Contractor Duke Drilling Co.

STATE OF KANSAS COUNTY OF BARTON, ss.

Larry Curtis (employee of owner) or (owner/operator)

of the above-described well, being first duly sworn on oath, says: That I have knowledge of the facts, statements, and matters herein contained and the log of the above-described well as filed and that the same are true and correct. So help me God.

(Signature)

*Larry Curtis*

Box 823, Great Bend, Kansas 67530

(Address)

SUBSCRIBED AND SWORN TO before me this 23rd day of June, 1976

*Barbara M. Hogue*  
Notary Public.

My commission expires April 11, 1978

RECEIVED  
STATE CORPORATION COMMISSION

JUN 28 1976

CONSERVATION DIVISION  
Wichita, Kansas

6-28-1976

## DRILLER' WELL LOG

DATE COMMENCED: June 16, 1976  
 DATE COMPLETED: June 22, 1976

L. D. Davis  
 KREY # 2  
 SW NE NW  
 Sec 14-T21-R13W  
 Stafford County, Kansas

0 - 125' Surface Soil, Sand and Hard Sand  
 125 - 281' Shale, Hard Sand, Sand  
 281 - 721' Red Bed  
 721 - 740' Anhydrite  
 740 - 1550' Shale  
 1550 - 3146' Lime and Shale  
 3146 - 3151' Shale  
 3151 - 3167' Lime and Shale  
 3167 - 3181' Lime  
 3181 - 3273' Shale  
 3273 - 3286' Lime and Shale  
 3286 - 3575' Lime, Shale, Chert  
 3575' RTD

ELEVATION: 1873' K.B.

## FORMATION TOPS

Anhydrite	721
Heebner	3146
Toronto	3167
Douglas	3181
Brown Lime	3273
Kansas City	3286
RTD	3575

## SURFACE PIPE:

Set used 8 5/8", 28# pipe @  
 305' w/225 sacks 50/50 Pozmix, 2%  
 Gel, 3% cc.

## A F F I D A V I T

STATE OF KANSAS )  
 COUNTY OF BARTON ) ss.

Larry Curtis, of lawful age, does swear and state that the facts and statements herein contained are true and correct to the best of his knowledge.

Larry Curtis

Subscribed and sworn to before me this 23rd day of June, 1976.

Dorothy M. Hague  
 Notary Public

My Commission Expires: April 11, 1978

RECEIVED  
 JUN 28 1976  
 COMMISSION  
 KANSAS