


STATE OF KANSAS
STATE CORPORATION COMMISSION

Give All Information Completely
Make Required Affidavit
Mail or Deliver Report to:
Conservation Division
State Corporation Commission
212 No. Market
Wichita, Kansas

WELL PLUGGING RECORD

NORTH

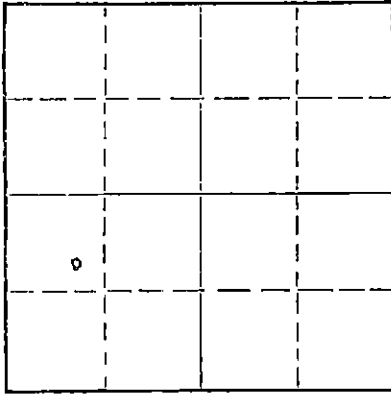

Locate well correctly on above
Section Plat

Stafford County, Sec. 14 Twp. 21 Rge. 13 (X) W (W)

Location as "NE/CNW%SW%" or footage from lines SE/4 NW/4 SW/4

Lease Owner Icer Addis

Lease Name WILBERT FANSHTER Well No. 1

Office Address Box 519, Great Bend, Kansas

Character of Well (completed as Oil, Gas or Dry Hole) Dry Hole

Date well completed Feb. 13 19 69

Application for plugging filed Feb. 13 19 69

Application for plugging approved " " 19 69

Plugging commenced Feb. 13 19 69

Plugging completed Feb. 13 19 69

Reason for abandonment of well or producing formation

If a producing well is abandoned, date of last production 19

Was permission obtained from the Conservation Division or its agents before plugging was commenced? yes

Name of Conservation Agent who supervised plugging of this well Ralph Warren

Producing formation Depth to top Bottom Total Depth of Well 3717 Feet

Show depth and thickness of all water, oil and gas formations.

OIL, GAS OR WATER RECORDS

CASING RECORD

FORMATION	CONTENT	FROM	TO	SIZE	PUT IN	PULLED OUT

Describe in detail the manner in which the well was plugged, indicating where the mud fluid was placed and the method or methods used in introducing it into the hole. If cement or other plugs were used, state the character of same and depth placed, from feet to feet for each plug set.

Hole full of mud - set plug, pump 50 sacks cement thru drill pipe to 500'
Pulled up to 350', pumped 25 sacks thru drill pipe.
Mud to 40', Plug, hulls, good bridge, pumped 10 sacks cement.
2 sacks cement in rat hole.

RECEIVED
STATE CORPORATION COMMISSION
FEB 17 1969
CONSERVATION DIVISION
Wichita, Kansas

(If additional description is necessary, use BACK of this sheet)

Name of Plugging Contractor
Address

STATE OF KANSAS, COUNTY OF BARTON, ss.
LARRY CURTIS (employee of owner) or (owner or operator) of the above-described well, being first duly sworn on oath, says: That I have knowledge of the facts, statements, and matters herein contained and the log of the above-described well as filed and that the same are true and correct. So help me God.

(Signature) Larry Curtis
Box 823 - Great Bend, Kansas
(Address)

SUBSCRIBED AND SWORN TO before me this 14 day of February, 19 69

My commission expires 4-11-70

Notary Public

W E L L L O G

DATE COMMENCED: January 3, 1969
 DATE COMPLETED: January 13, 1969

Icer Addis
 WILBERT FANSHIER #1
 SE/4 NW/4 SW/4
 Section 14, T21s, R13W
 Stafford County, Kansas

ELEVATION: 1876 K&B.

0 - 80' Clay & Sand
 80 - 88' Iron
 88 - 355' Clay & Sand
 355 - 729' Red Bed
 729 - 750' Anhydrite
 750 - 1600' Shale - Shells
 1600 - 2560' Lime - Shale
 2560 - 2803' Shale & Lime
 2803 - 2880' Lime - Shale
 2880 - 3171' Lime
 3171 - 3184' Shale
 3184 - 3200' Lime
 3200 - 3300' Shale
 3300 - 3313' Lime, brown
 3313 - 3533' Lime
 3533 - 3550' Lime & Shale
 3550 - 3603' Conglomerate
 3603 - 3613' Chert
 3613 - 3640' Simpson Shale
 3640 - 3717' Dolomite

FORMATION DATA

ANHYDRITE	729
HOWARD	2803
TOPEKA	2880
HEEBNER	3171
TORONTO	3184
DOUGLAS	3200
BROWN LIME	3300
LANSING	3313
BASE K.E.	3533
CONGLOMERATE	3550
VIOLA	3603
SIMPSON SHALE	3613
ARBUCKLE	3640
RTD	3717

RECEIVED
 STATE CORPORATION COMMISSION
 FEB 17 1969
 CONSERVATION DIVISION
 Wichita, Kansas

SURFACE PIPE: Set new 8-5/8" 20# at 386' with 250 sacks cement.

A F F I D A V I T

STATE OF KANSAS
 COUNTY OF BARTON) ss.

Larry Curtis, of lawful age, does swear and state that the facts and statements herein contained are true and correct to the best of his knowledge.

Larry Curtis

Subscribed and sworn to before me this 14 day of February,, 1969.

My Comm. Expires:
April 11, 1970

Dorothy M. Lague
 Notary Public