


WELL PLUGGING RECORD

Give All Information Completely
Make Required Affidavit
Mail or Deliver Report to:
Conservation Division
State Corporation Commission
211 No. Broadway
Wichita, Kansas

NORTH

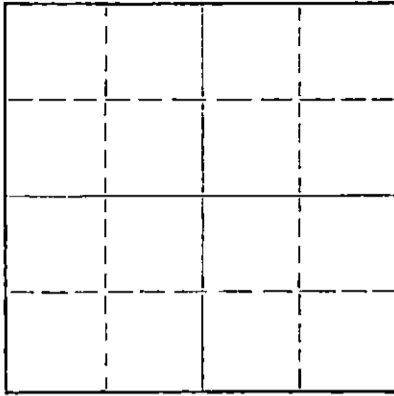

Locate well correctly on above
Section Plat

Stafford County. Sec. 14 Twp. 21S Rge. 13 ~~XX~~ (W)
Location as "NE/CNW/SW" or footage from lines SW SW SW
Lease Owner Sierra Petroleum Company, Inc.
Lease Name C. M. Fanshier Well No. #1
Office Address 420 West Douglas Ave., Wichita, Kansas
Character of Well (completed as Oil, Gas or Dry Hole) Dry
Date well completed 11/3/56 19
Application for plugging filed 11/2/56 19
Application for plugging approved 11/2/56 19
Plugging commenced 11/3/56 19
Plugging completed 11/3/56 19
Reason for abandonment of well or producing formation Dry

If a producing well is abandoned, date of last production _____ 19
Was permission obtained from the Conservation Division or its agents before plugging was commenced? Yes

Name of Conservation Agent who supervised plugging of this well Mr. Brundage
Producing formation _____ Depth to top _____ Bottom _____ Total Depth of Well 3740' Feet
Show depth and thickness of all water, oil and gas formations.

OIL, GAS OR WATER RECORDS

CASING RECORD

FORMATION	CONTENT	FROM	TO	SIZE	PUT IN	PULLED OUT
				8 5/8"	219	None

Describe in detail the manner in which the well was plugged, indicating where the mud fluid was placed and the method or methods used in introducing it into the hole. If cement or other plugs were used, state the character of same and depth placed, from _____ feet to _____ feet for each plug set.

PLUGGING REPORT

Filled hole with heavy mud from 3740' to 210'. 210' to 170' with 1/3 sack hulls, wood plug and 20 sacks cement through drill pipe. From 170' up to 35' filled with heavy mud. From 35' to 0', cellar, filled with 1/3 sack hulls, wood plug, and 10 sacks cement. Job completed at 7:00 Am 11/3/56. Mr. Mr. Brundage.

(If additional description is necessary, use BACK of this sheet)

Name of Plugging Contractor Sierra Petroleum Company, Inc.
Address 420 West Douglas Ave. Wichita, Kansas

STATE OF KANSAS, COUNTY OF RUSSELL, ss.
C. T. Honaker (employee of owner) or (owner or operator) of the above-described well, being first duly sworn on oath, says: That I have knowledge of the facts, statements, and matters herein contained and the log of the above-described well as filed and that the same are true and correct. So help me God.

(Signature) C. T. Honaker
Great Ben, Kansas
(Address)

SUBSCRIBED AND SWORN to before me this 6th day of November, 1956

My commission expires 10/17/59

Gray Ditty
Notary Public.

PLUGGING
FILE SEC. 14 T. 21 R. 13W
BOOK PAGE 113 LINE 28

RECEIVED
STATE CORPORATION COMMISSION

11-8-1956

SIERRA PETROLEUM COMPANY, INC.
C. M. Fanshier #1

SW SW SW Sec. 14-21S-13W
Stafford County, Kansas

Total Depth: 3740'

Elev: 1876' KB

Comm: 10/23/56
Comp: 11/3/56

Casing
8 5/8" @ 219'

Cement
150 sacks Bulk Cement

FORMATION	DEPTH
Clay & sand	30
Sand & shale	180
Shale	219
Shale & sand	375
Redbed	465
Redbed & shale	730
Shale & shells	760
Shale & lime	1980
Lime	2040
Lime & shale	3310
Lime	3508
Lime & shale	3572
Lime & sand	3632
Lime & shale	3661
Lime	3725
Arbuckle	3740
TOPS:	
Hebner	3168-1292
Tronto	3188-1313
B/Lime	3296-1420
Kansas City	3309-1433
Base Kansas City	3533-1657
Conglomerate	3554-1678
Viola	3559-1683
Simpson	3599-1723
Arbuckle	3730-1854

STATE OF KANSAS)
) ss:
COUNTY OF RUSSELL)

I hereby certify that the above information is true and correct to the best of my knowledge.

C. P. Honaker

Subscribed and sworn to before me this 16th day of November, 1956.

Leroy Dietz
Notary Public

My commission expires: 10/17/59

PLUGGING
FILE SEC 14 T 21 R 13W
BOOK PAGE 113 LI E 28

RECEIVED
STATE CORPORATION COMMISSION
NOV - 3 1956
CONSERVATION DIVISION
Wichita, Kansas