


STATE OF KANSAS
STATE CORPORATION COMMISSION

WELL PLUGGING RECORD

Give All Information Completely
Make Required Affidavit
Mail or Deliver Report to:
Conservation Division
State Corporation Commission
800 Bittling Building
Wichita, Kansas

Stafford County. Sec. 18 Twp. 21S Rge. 12 N. (W)
Location as "NE/CNW $\frac{1}{4}$ SW $\frac{1}{4}$ " or footage from lines SW SW NE
Lease Owner Honaker Drilling Co., Inc., et al
Lease Name Christiansen Well No. 2
Office Address Great Bend, Kansas
Character of Well (completed as Oil, Gas or Dry Hole) Dry
Date well completed March 17, 19 51
Application for plugging filed March 17, 19 51
Application for plugging approved March 17, 19 51
Plugging commenced March 17, 19 51
Plugging completed March 17, 19 51
Reason for abandonment of well or producing formation Dry

NORTH

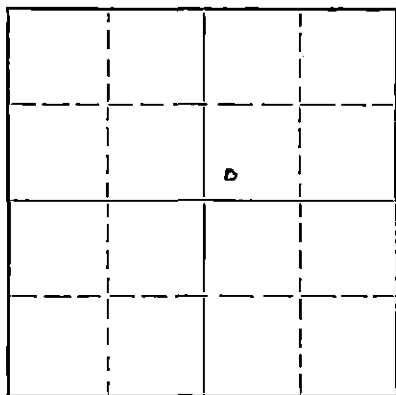

Locate well correctly on above
Section Plat

If a producing well is abandoned, date of last production 19
Was permission obtained from the Conservation Division or its agents before plugging was com-
menced? Yes

Name of Conservation Agent who supervised plugging of this well C. D. Stough
Producing formation Depth to top Bottom Total Depth of Well 3626 Feet
Show depth and thickness of all water, oil and gas formations.

OIL, GAS OR WATER RECORDS

CASING RECORD

Formation	Content	From	To	Size	Put In	Pulled Out
				8-5/8	360	none

Describe in detail the manner in which the well was plugged, indicating where the mud fluid was placed and the method or methods used in introducing it into the hole. If cement or other plugs were used, state the character of same and depth placed, from feet to feet for each plug set.

Filled hole with heavy mud to 310'. Bridged with Wooden Plug and plugged with 15 sacks cement down drill pipe and then filled with heavy mud to 30'. Bridged with Wooden Plug and filled with 10 sacks cement to bottom of cellar.

RECEIVED
STATE CORPORATION COMMISSION
APR 27 1951
CONSERVATION DIVISION
Wichita, Kansas

4-27-51

(If additional description is necessary, use BACK of this sheet)
Correspondence regarding this well should be addressed to Honaker Drilling Co., Inc.
Address Great Bend, Kansas

STATE OF Kansas, COUNTY OF Barton, ss.
C. L. Miles (employee of owner) or (owner or operator) of the above-described well,

being first duly sworn on oath, says: That I have knowledge of the facts, statements, and matters herein contained and the log of the above-described well as filed and that the same are true and correct. So help me God.

(Signature) C. L. Miles
Great Bend, Kansas (Address)

SUBSCRIBED AND SWORN TO before me this 25th day of April, 19 51

L. E. Caraway
Notary Public.

My commission expires 9-1-54

PLUGGING
FILE SEC. 18 T. 21 S. R. 12
BOOK PAGE 67 LINE 38

DRILLERS LOG

Operator: Honaker Drilling Co., Inc., et al

Contractor: Transit Corp.

Lease: Christianson #2

	From	To
Surface sand & Gravel	0	207
Red Bed, Shale & Shells	207	340
Red Bed	340	360

Run 9 joints, 360' 3-5/8 casing, cemented with 250 sacks cement @ 359'.

C O P Y	Plug Cement	345	360	
	Red Bed	360	698	
	Anhydrite	698	732 732	
	Shale & Shells	732	1130	
	Shale & Shells	1130	1475	
	Shale & Lime	1475	1705	
	Lime	1705	1945	
	Lime & Shale	1945	2180	
	Shale & Shells	2180	2772	
	Lime	2772	3175	
	Shale & Shells	3175	3260	
	Shale & Lime	3260	3362	
	Lime	3362	3544	
	Lime & Shale	3544	3582	
Lime, Chert, Shale	3582	3616		
Chert, Sand, Lime	3616	3626	T. D.	

D & A.

The foregoing is correct to the best of my knowledge.

Transit Corp.

By _____

APR 27 1951
 CONSERVATION DIVISION
 Wichita, Kansas

PLUGGING
 FILE SEC-18T-XR/120
 BOOK PAGE-67-LINE-31