

STATE OF KANSAS  
STATE CORPORATION COMMISSION

WELL PLUGGING RECORD


Give All Information Completely  
Make Required Affidavit  
Must of Deliver Report to:  
Conservation Division  
State Corporation Commission  
800 Bittig Building  
Wichita, Kansas

OR

FORMATION PLUGGING RECORD

Strike out upper line  
when reporting plug-  
ging of formations.

*Stafford* County, Sec. *18* Twp. *21* Rge. *17* (W)  
Location as "NE/4 NW/4 SW/4" or footage from lines *NW 1/4 NE 1/4 SW 1/4 18-21-12W*

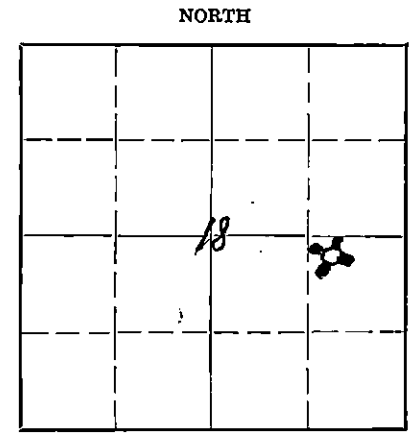

Locate well correctly on above  
Section Plat

Lease Owner *W. P. Faulkner*  
Lease Name *James Welsh* Well No. \_\_\_\_\_  
Office Address *409 First Natl Bldg Wichita, Ks*  
Character of Well (completed as Oil, Gas or Dry Hole) *Dry Hole*  
Date well completed *April 16 - 1944* 19 *44*  
Application for plugging filed *17* 19 *44*  
Application for plugging approved *17* 19 *44*  
Plugging commenced *17* 19 *44*  
Plugging completed *17* 19 *44*  
Reason for abandonment of well or producing formation *Dry Hole*

If a producing well is abandoned, date of last production \_\_\_\_\_ 19 \_\_\_\_  
Was permission obtained from the Conservation Division or its agents before plugging was com-  
menced? *yes*

Name of Conservation Agent who supervised plugging of this well \_\_\_\_\_  
Producing formation *Arbuckle 3644* Depth to top \_\_\_\_\_ Bottom \_\_\_\_\_ Total Depth of Well *3649* Feet  
Show depth and thickness of all water, oil and gas formations.

OIL, GAS OR WATER RECORDS


CASING RECORD

Formation	Content	From	To	Size	Put In	Pulled Out
<i>Arbuckle</i>	<i>Dry</i>	<i>3644</i>	<i>3649</i>	<i>7 7/8</i>		<i>None</i>

Describe in detail the manner in which the well was plugged, indicating where the mud fluid was placed and the method or methods used in introducing it into the hold. If cement or other plugs were used, state the character of same and depth placed, from \_\_\_\_\_ feet to \_\_\_\_\_ feet for each plug set.

*8-19-44*

**PLUGGING**  
FILE *18-21-12W*  
BOOK *PAG 114 LINE 24*

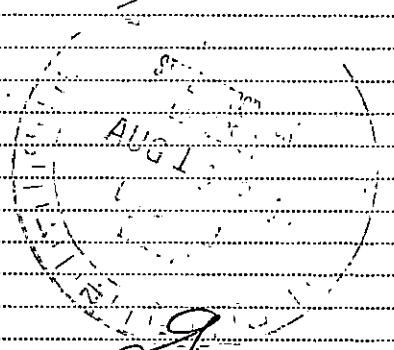

(If additional description is necessary, use BACK of this sheet)  
Correspondence regarding this well should be addressed to \_\_\_\_\_  
Address *409 First Natl Bldg Wichita, Kansas*

STATE OF Kansas COUNTY OF Sedgwick ss.  
W. P. Faulkner (employee of owner) or (owner or operator) of the above-described well,

being first duly sworn on oath, says: That I have knowledge of the facts, statements, and matters herein contained and the log of the above-described well as filed and that the same are true and correct. So help me God.

(Signature) *W. P. Faulkner*  
409 First National Bk. Bldg.  
(Address)

SUBSCRIBED AND SWORN to before me this *24th* day of *April*, 19 *44*

My commission expires *Jan. 14, 1948*  
*Eloise Russell*  
Notary Public.

## WELL LOG

Company: Faulkner Oil Company--Wichita, Kansas.  
 Lease : Welch B 1, Stafford County, Kansas.  
 Contractor: Campbell & Kuhn--Wichita, Kansas.  
 Well Started: March 28, 1944  
 Surface Casing: 290 feet of 8 5/8 O.D. Casing- 100 sbs cement  
 Well finished: April 16, 1944

From	To	
0	215	Sand
215	290	Sand Rock Shells
290	292	Surface Casing
290	480	Red Bed
480	675	Red Bed
675	710	Anhydrite
710	805	Shale & Shells
805	1065	Shale & Shells
1065	1205	Shale & Shells
1205	1290	Salt & Shale
1290	1360	Salt & Shale
1360	1490	Shale & Shells
1490	1605	Shale & Shells
1605	1630	Lime
1630	1690	Broken Lime
1690	1750	Lime & Shale
1750	1810	Lime & Shale
1810	1840	Lime & Shale
1840	1870	Sandy Lime
1870	1890	Shale
1890	1915	Shale
1915	1940	Lime
1940	1990	Lime & Shale
1990	2050	Shale
2050	2135	Shale & Shells
2135	2210	Shale & Lime
2210	2265	Shale & Lime
2265	2285	Sandy Lime
2285	2300	Lime
2300	2350	Lime
2350	2370	Shale & Lime
2370	2450	Shale & Lime
2450	2530	Shale
2530	2570	shale
2570	2605	Shale & Lime
2605	2665	Lime & Shale
2665	2730	Shale & Lime
2730	2770	Shale & Lime
2770	2778	Lime
2778	2840	Lime & Shale
2840	2875	Shale
2875	2905	Broken Lime
2905	2920	Lime
2920	2960	Lime
2960	3005	Lime
3005	3015	Lime
3015	3040	Shale & Lime
3040	3065	Sandy Lime
3065	3090	Lime
3090	3140	Lime
3140	3155	Shale
3155	3190	Lime & Shale
3190	3235	Shale
3235	3268	Shale & Lime
3268	3311	Lime & Shale
3311	3359	Lime
3359	3397	Lime
3397	3423	Lime & Shale
3423	3474	Lime
3474	3518	Lime
3518	3535	Lime & shale
3535	3559	Lime, Chirt & shale
3559	3570	Chirt
3570	3583	Chirt & shale
3583		Drill stem test
3583	3616	Chirt & shale
3616	3650	Shale
3650		Plugged hole

WICHITA COUNTY  
 MAR 16 1944

**PLUGGING**  
 FILE SEC 11 T 21 R 12 W  
 BOOK PAGE 144 LINE 24